

Locate well and acreage of irrigated land on plat. Scale: 2" = 1 Mile

STATE OF OREGON }
County of Clackamas } ss.

I, Ronald G. Tatone, being first duly sworn, do hereby certify that I have read the foregoing Registration Statement and that all of the items therein contained are true to the best of my knowledge and belief.

Ronald G. Tatone
(Signature of Registrant)

Subscribed and sworn to before me this 11 day of Sept, 1954

My commission expires 2-29-1960

H.B. Evans
(Notary Public)

(SEAL)

SEE PAGE GR-266-K FOR CERTIFICATE OF REGISTRATION

STATE OF OREGON }
County of Marion } ss.




Witness my hand this _____ day of _____, 19_____

(State Engineer)

By _____ (Deputy)

North

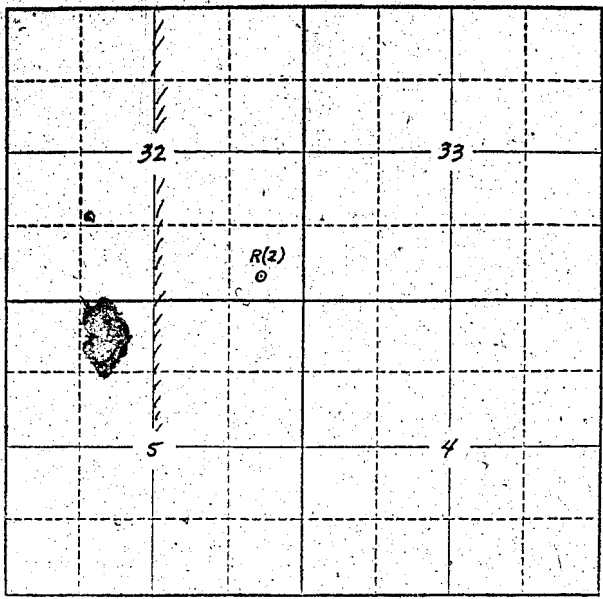

Locate well and acreage of irrigated land on plat.
Scale: 2" = 1 Mile

STATE OF OREGON

County of Clackamas } ss.

I, Ronald G. Tatone, being first duly sworn, do hereby certify that I have read the foregoing Registration Statement and that all of the items therein contained are true to the best of my knowledge and belief.

Ronald G. Tatone
(Signature of Registrant)

Subscribed and sworn to before me this 11 day of Sept, 1956

My commission expires 2-29-1960

(Notary Public)

(SEAL)

SEE PAGE GR-266-K FOR
CERTIFICATE OF REGISTRATION

STATE OF OREGON

County of Marion } ss.

~~This is to certify that the foregoing Registration Statement was recorded in the office of the State Engineer on this day of at which time the same was read and approved by me and the same is hereby recorded in my office in Book No. Registration Statement entered on the records of the State Engineer in the county of Oregon on this day of 1956.~~

Witness my hand this day of 19

(State Engineer)

By (Deputy)

