


North

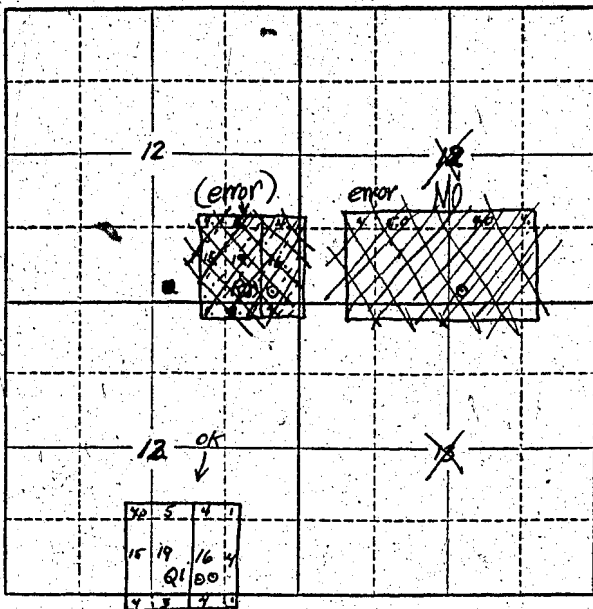

Locate well and acreage of irrigated land on plat.

Scale: 2" = 1 Mile

STATE OF OREGON

County of Marion } ss.

I, Noble T. Bradley, being first duly sworn, do hereby certify that I have read the foregoing Registration Statement and that all of the items therein contained are true to the best of my knowledge and belief.

Noble T. Bradley (Signature of Registrant)

Subscribed and sworn to before me this 15th day of November, 1958.

My commission expires January 11, 1958. Ruth V. Lusk (Notary Public)

(SEAL)

SEE PAGE GR-276-G FOR CERTIFICATE OF REGISTRATION

STATE OF OREGON } ss. County of Marion


Witness my hand this _____ day of _____, 19_____

(State Engineer)

By _____ (Deputy)

