Township 1N Range 3E W.M. SP&S

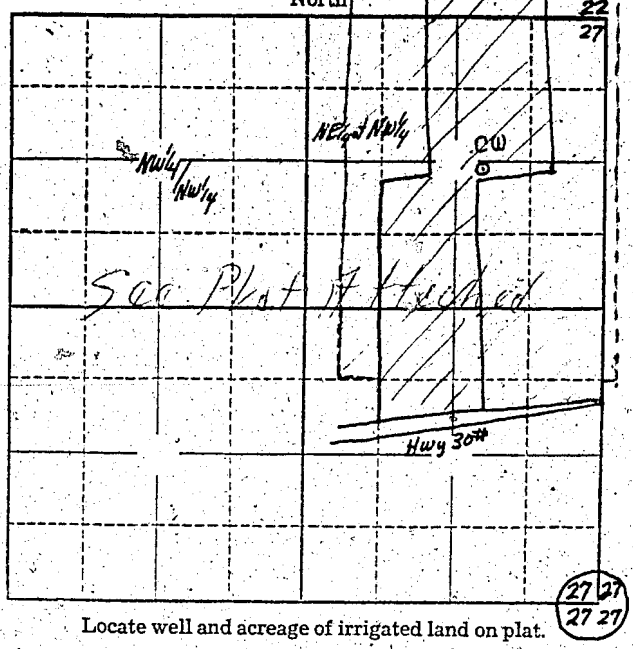

Locate well and acreage of irrigated land on plat.

Scale: ~~1"~~ 8" = 1 Mile

STATE OF OREGON
County of ..... } ss.

I, FRANK KASER, being first duly sworn, do hereby certify that I have read the foregoing Registration Statement and that all of the items therein contained are true to the best of my knowledge and belief.

Frank Kaser
(Signature of Registrant)

Subscribed and sworn to before me this 4th day of October, 1956

My commission expires July 29, 1958 Lucile H. Robinson
(Notary Public)

(SEAL)

CERTIFICATE OF REGISTRATION

STATE OF OREGON
County of Marion } ss.

This is to certify that the foregoing Registration Statement was received in the office of the State Engineer on the 20th day of November, 19 56, at 8 o'clock ~~A. M.~~ and has been duly recorded in said office in Book No. 2 of Registration Statements on page GR-280-C

~~Construction Permit was issued by X-X-X-X-X-X-X-X-X-19X-X-and the water was put to beneficial use on X-X-X-X-X-X-X-X-X-