


SE  $\frac{1}{4}$  of Sec. 33

Center Township 6 N. Range 35 E. W.M. North

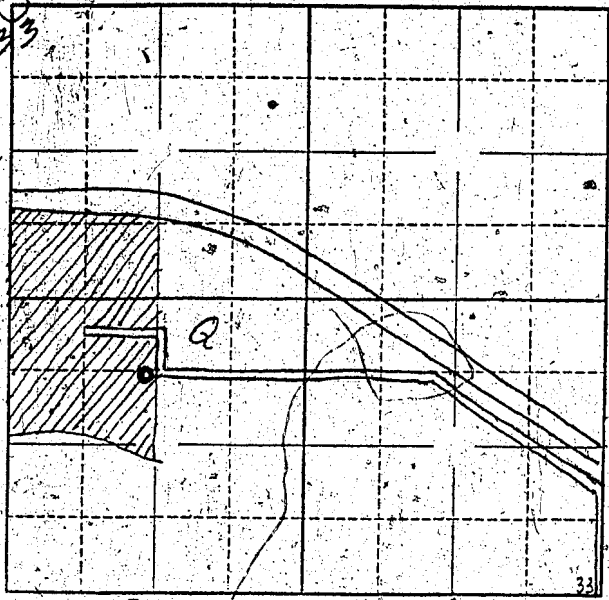

Locate well and acreage of irrigated land on plat.

Scale: 8" = 1 Mile

STATE OF OREGON

County of Washington ss.

I, Ray D. Kelly, being first duly sworn, do hereby certify that I have read the foregoing Registration Statement and that all of the items therein contained are true to the best of my knowledge and belief.

*Ray D. Kelly*  
(Signature of Registrant)

Subscribed and sworn to before me this 21 day of July, 1958.

My commission expires 1961 9 17 59

(Notary Public)

(SEAL)

CERTIFICATE OF REGISTRATION

STATE OF OREGON }  
County of Marion } ss.

This is to certify that the foregoing Registration Statement was received in the office of the State Engineer on the 29 day of July, 1958, at 1:00 o'clock P. M. and has been duly recorded in said office in Book No. 12 of Registration Statements on page GR 2824

Witness my hand this 25<sup>th</sup> day of May, 1959

*Lewis A. Stanley*  
(State Engineer)

By \_\_\_\_\_ (Deputy)

GR - 2824

#1500