Township 9 S Range 42 E, W.M.

North

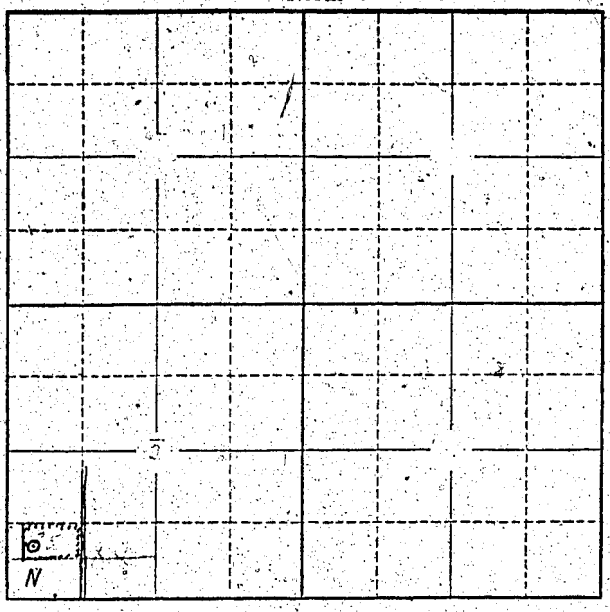

Locate well and acreage of irrigated land oh plat.

Scale: 2" = 1 Mile

STATE OF OREGON
County of Baker } ss.

I, Edith H. Miller, being first duly sworn, do hereby certify that I have read the foregoing Registration Statement and that all of the items therein contained are true to the best of my knowledge and belief.

(Signature of Registrant)

Subscribed and sworn to before me this 28th day of July, 1958

My commission expires .....

(Notary Public)

(SEAL)

NOTARY PUBLIC FOR OREGON
My Commission Expires July 15, 1960

CERTIFICATE OF REGISTRATION

STATE OF OREGON
County of Marion } ss.

This is to certify that the foregoing Registration Statement was received in the office of the State Engineer on the 29 day of July, 1958, at 1:00 o'clock P M. and has been duly recorded in said office in Book No. 12 of Registration Statements on page GR-2826

Witness my hand this 25th day of May, 1959

(State Engineer)

By .....
(Deputy)

$15.00

GR-2826