


Township 35 Range 29 E, W.M.

North

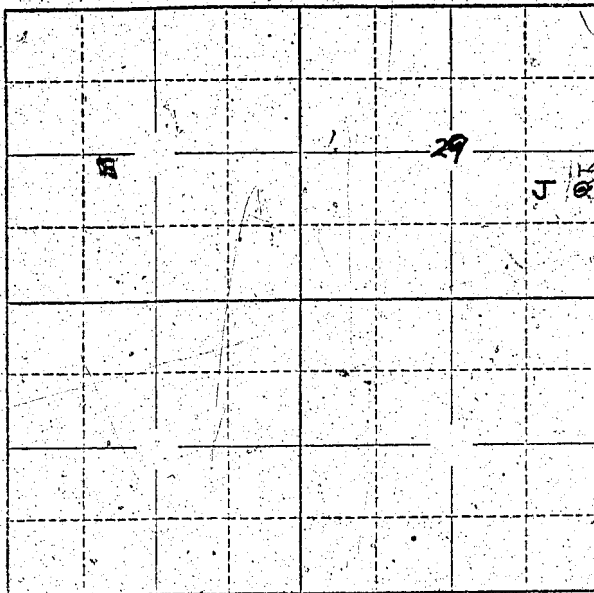

Locate well and acreage of irrigated land on plat.

Scale: 2" = 1 Mile

STATE OF OREGON

County of Morrow

ss.

I, Victor Groshens, being first duly sworn, do hereby certify that I have read the foregoing Registration Statement and that all of the items therein contained are true to the best of my knowledge and belief.

Victor Groshens  
(Signature of Registrant)

Subscribed and sworn to before me this 9th day of July, 1958

My commission expires January 1, 1961

Delores Daman  
(Notary Public)

(SEAL)

**CERTIFICATE OF REGISTRATION**

STATE OF OREGON

County of Marion

ss.

This is to certify that the foregoing Registration Statement was received in the office of the State Engineer on the 30th day of July, 1958, at 8:00 o'clock A.M. and has been duly recorded in said office in Book No. 16 of Registration Statements on page 6R-4033.

~~Construction shall be completed by 19 and the water completely applied to beneficial use by 19.~~

Witness my hand this 11th day of April, 1960

Laura A. Steiner  
(State Engineer)

By

(Deputy)

OR-4033

\$ 20.00