


Township 35 Range 1E, W.M.  
North

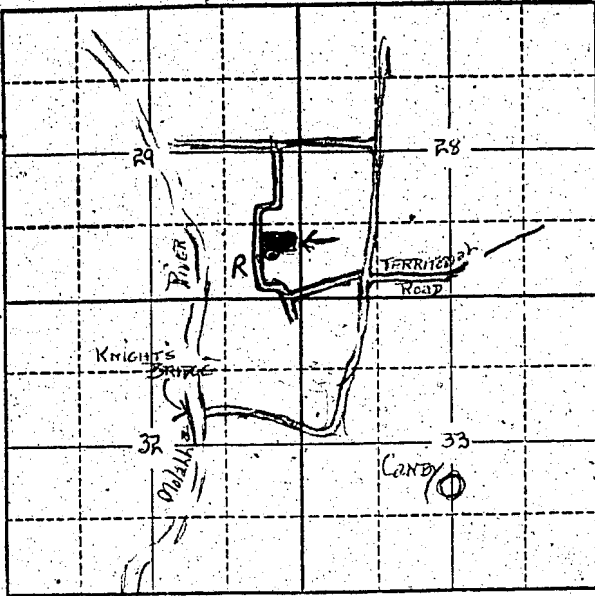

Locate well and acreage of irrigated land on plat.  
Scale: 2" = 1 Mile

STATE OF OREGON  
County of Marion } ss.

I, \_\_\_\_\_, being first duly sworn, do hereby certify that I have read the foregoing Registration Statement and that all of the items therein contained are true to the best of my knowledge and belief.

Fred H. Lovest  
(Signature of Registrant)

Subscribed and sworn to before me this 29 day of July, 1958

My commission expires MY COMMISSION EXPIRES APRIL 3, 1962  
W. E. Fisher  
(Notary Public)

(SEAL)

**CERTIFICATE OF REGISTRATION**

STATE OF OREGON  
County of Marion } ss.

This is to certify that the foregoing Registration Statement was received in the office of the State Engineer on the 30 day of July, 1958, at 5:00 o'clock A. M. and has been duly recorded in said office in Book No. 12 of Registration Statements on page GR-2861

With my hand this 25<sup>th</sup> day of May, 1959  
Lewis J. Stanley  
(State Engineer)

By \_\_\_\_\_ (Deputy)

\$15.00