


North

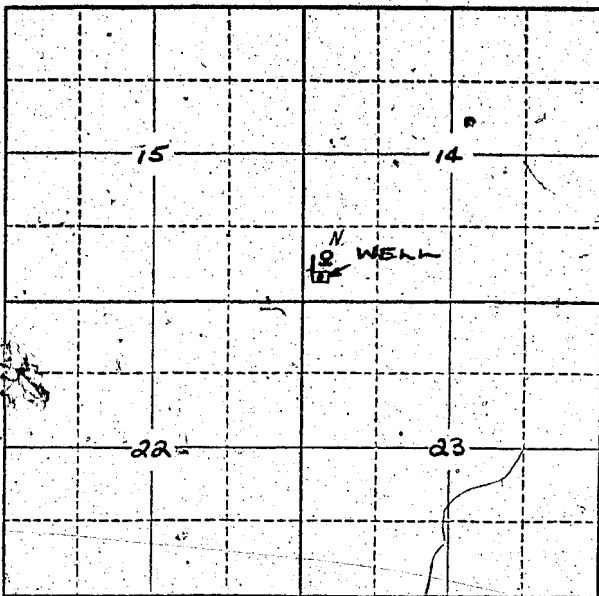

Locate well and acreage of irrigated land on plat.

Scale: 2" = 1 Mile

STATE OF OREGON

County of Lackness

} ss.

I, Robert Wiedemann, being first duly sworn, do hereby certify that I have read the foregoing Registration Statement and that all of the items therein contained are true to the best of my knowledge and belief.

Wiedemann Book by Robert Wiedemann
(Signature of Registrant)

Subscribed and sworn to before me this 28 day of July, 1958.

My commission expires

Rebecca L. Adams
(Notary Public)

(SEAL)

CERTIFICATE OF REGISTRATION

STATE OF OREGON

County of Marion

} ss.

This is to certify that the foregoing Registration Statement was received in the office of the State Engineer on the 30th day of _____, 1958, at 8:00 o'clock A.M. and has been duly recorded in said office in Book No. 16 of Registration Statements on page GR 3790

Witness my hand this 20th day of November, 1959

Lewis A. Stanley
(State Engineer)

By

(Deputy)

#15.00