


Township 9 S Range 1 W, W.M.
North

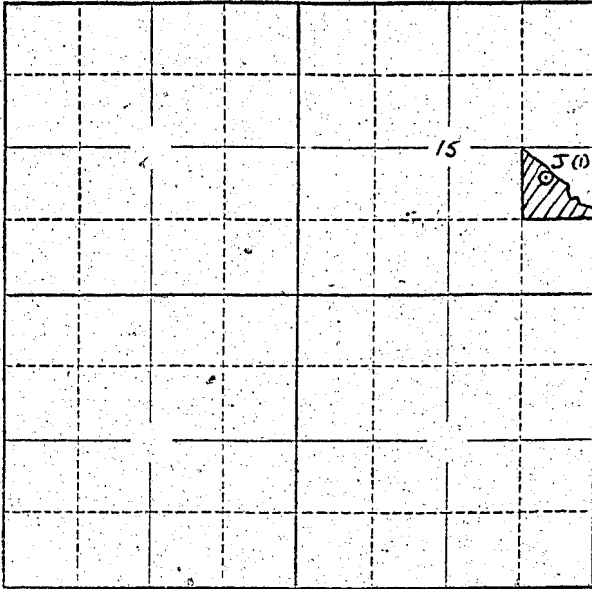

Locate well and acreage of irrigated land on plat.

Scale: 2" = 1 Mile

STATE OF OREGON

County of Marion } ss.

I, DeWitt Taylor, being first duly sworn, do hereby certify that I have read the foregoing Registration Statement and that all of the items therein contained are true to the best of my knowledge and belief.

(Signature of Registrant)

Subscribed and sworn to before me this 26 day of Sept, 1956.

My commission expires 3/21/59

(Notary Public)

(SEAL)

SEE PAGE GR-285-G FOR
CERTIFICATE OF REGISTRATION

STATE OF OREGON

County of Marion } ss.

~~This is to certify that the foregoing Registration Statement was received in the office of the State Engineer on the 10th day of September 1956 and has been filed in the State Engineer's Office and that the same is a true and correct copy of the original as filed in the State Engineer's Office.~~


Witness my hand this 26 day of Sept, 1956

(State Engineer)

By _____
(Deputy)

GR-285 C

North

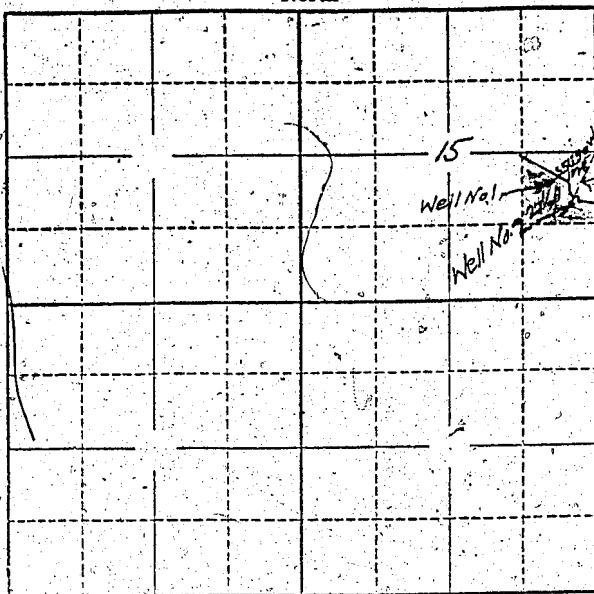

Scale: 2" = 1 Mile

County of Marion

(Signature of Registrant):

My commission expires 8/21/58

(Notary Public)

(SEAL)

CERTIFICATE OF REGISTRATION

STATE OF OREGON }
County of Marion } ss.

Construction shall be completed x-x-x-x-x-x-x-x-x-x-19-x-x and the water completely x applied to

X-1-A-X-X-X-X-X-X-X-X-X-X-X-X-X-X-X

Witness my hand this 15th day of January, 19 57.

(State Engineer

By _____ (Deputy)

GR-285G