


North

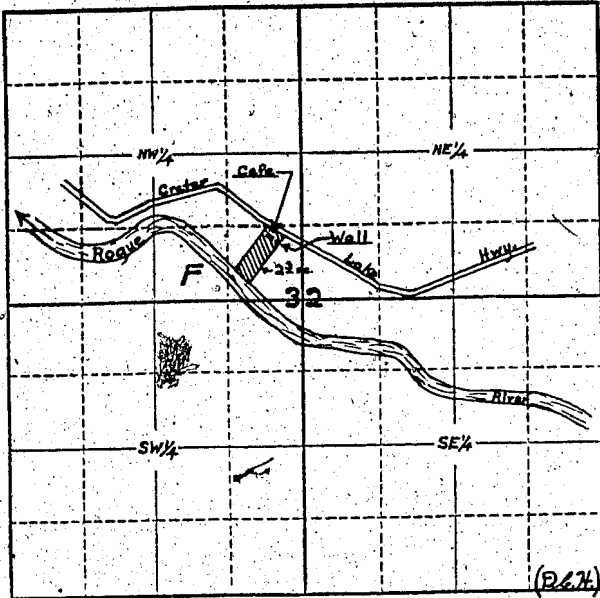

Locate well and acreage of irrigated land on plat.

Scale: 4" = 1 Mile

STATE OF OREGON

County of Jackson

} ss.

I, Mrs. Carolyn H. Kelsey, being first duly sworn, do hereby certify that I have read the foregoing Registration Statement and that all of the items therein contained are true to the best of my knowledge and belief.

X *Carolyn H. Kelsey*
(Signature of Registrant)

Subscribed and sworn to before me this 28th day of July, 1958

My commission expires August 25, 1958

[Signature]
(Notary Public)

(SEAL)

CERTIFICATE OF REGISTRATION

STATE OF OREGON

County of Marion

} ss.

This is to certify that the foregoing Registration Statement was received in the office of the State Engineer on the 30th day of July, 1958, at 8:00 o'clock A.M. and has been duly recorded in said office in Book No. 12 of Registration Statements on page GR-2865

Witness my hand this 25th day of May 1959

Laura A. Stanley
(State Engineer)

By _____ (Deputy)

GR - 2865

25.00