


Township 9.5 Range 4W W.M.

North

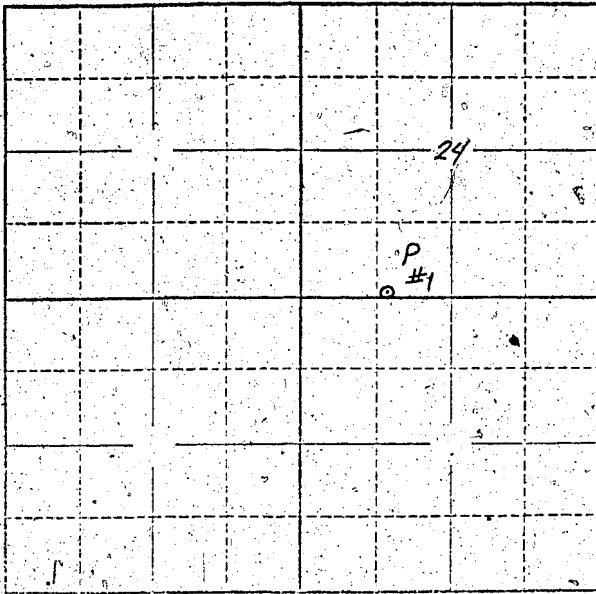

Locate well and acreage of irrigated land on plat.

Scale: 2" = 1 Mile

STATE OF OREGON

County of Marion

SS:

I, William Krebs, being first duly sworn, do hereby certify that I have read the foregoing Registration Statement and that all of the items therein contained are true to the best of my knowledge and belief.

William Krebs
(Signature of Registrant)

Subscribed and sworn to before me this 28 day of July, 1958

My commission expires April 6, 1959
Wm. B. Cline
(Notary Public)

(SEAL)

CERTIFICATE OF REGISTRATION

STATE OF OREGON

County of Marion

SS.

This is to certify that the foregoing Registration Statement was received in the office of the State Engineer on the 30th day of July, 1958, at 2⁰⁰ o'clock P.M. and has been duly recorded in said office in Book No. 12 of Registration Statements on page GR-2875


Witness my hand this 25th day of May, 1959

Lenie A. Stanley
(State Engineer)

By _____ (Deputy)

\$ 27.⁸⁵

GR-2875