


Township 13s Range 5W, W.M.

North

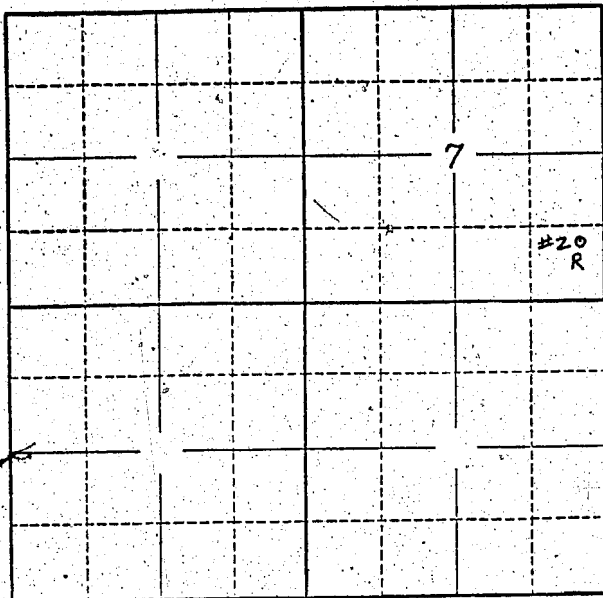

Locate well and acreage of irrigated land on plat.

Scale: 2" = 1 Mile

STATE OF OREGON

County of Marion } ss.

I, Earl Lillaspie, being first duly sworn, do hereby certify that I have read the foregoing Registration Statement and that all of the items therein contained are true to the best of my knowledge and belief.

Earl Lillaspie
(Signature of Registrant)

Subscribed and sworn to before me this 30th day of July, 19 58

My commission expires 12th June 1961 Wm. S. Bartholomew
(Notary Public)

(SEAL)

CERTIFICATE OF REGISTRATION

STATE OF OREGON }
County of Marion } ss.

This is to certify that the foregoing Registration Statement was received in the office of the State Engineer on the 30th day of July, 19 58, at 10:00 o'clock A. M. and has been duly recorded in said office in Book No. 12 of Registration Statements on page GR 2880

Witness my hand this 25th day of May, 19 59

Lewis A. Stanley
(State Engineer)

By _____
(Deputy)

GR - 2880

\$16.80