Township 11 S. Range 4 W., W.M.

North

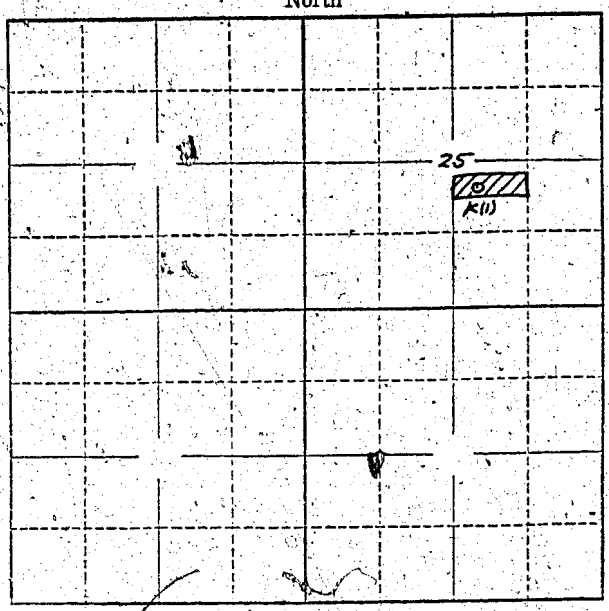

Locate well and acreage of irrigated land on plat.

Scale: 2" = 1 Mile

STATE OF OREGON
County of Linn } ss.

I, Loren A. and Mildred A. Campbell, being first duly sworn, do hereby certify that I have read the foregoing Registration Statement and that all of the items therein contained are true to the best of my knowledge and belief.

Loren A. Campbell
(Signature of Registrant)
Mildred A. Campbell

Subscribed and sworn to before me this 30th day of November, 1956.

My commission expires Aug 4, 1957 Saronalee Strait
(Notary Public)

(SEAL)

CERTIFICATE OF REGISTRATION

STATE OF OREGON
County of Marion } ss.

This is to certify that the foregoing Registration Statement was received in the office of the State Engineer on the 3rd day of December, 1956, at 12 o'clock A. M. and has been duly recorded in said office in Book No. 2 of Registration Statements on page GR-288-C

~~[illegible]~~

~~[illegible]~~

Witness my hand this 15th day of January, 1957.

Lewis A. Stanley
(State Engineer)

By
(Deputy)

GR-288 C