


Township 45 Range 4 W, W.M.

North

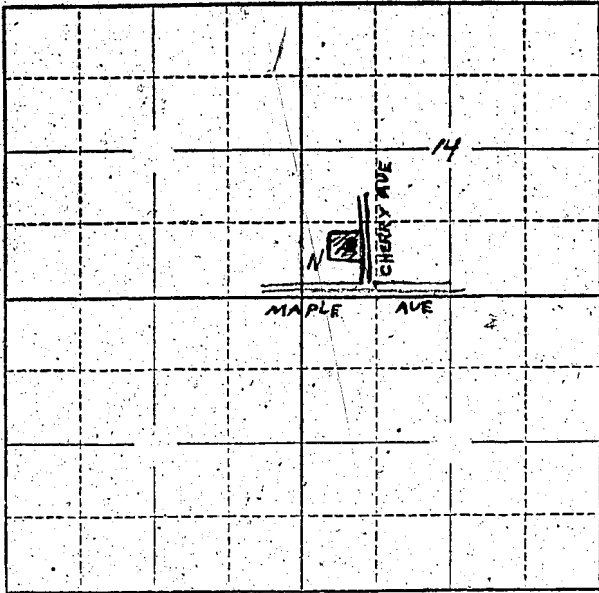

Locate well and acreage of irrigated land on plat.  
Scale: 2" = 1 Mile

STATE OF OREGON

County of Yamhill } ss.

I, Arthur Ptacek, being first duly sworn, do hereby certify that I have read the foregoing Registration Statement and that all of the items therein contained are true to the best of my knowledge and belief.

*Arthur Ptacek*  
(Signature of Registrant)

Subscribed and sworn to before me this 29 day of July, 1958.

My commission expires October 20, 1960  
*James C. Ginn*  
(Notary Public)

(SEAL)

**CERTIFICATE OF REGISTRATION**

STATE OF OREGON } ss.  
County of Marion

This is to certify that the foregoing Registration Statement was received in the office of the State Engineer on the 30th day of July, 1958, at 8:00 o'clock A. M. and has been duly recorded in said office in Book No. 12 of Registration Statements on page GR-2901

~~Construction work has been completed by [unclear] and the water completely applied to beneficial use by [unclear] on [unclear].~~

Witness my hand this 25th day of May, 1959.

*Stuvia G. Stanley*  
(State Engineer)

By \_\_\_\_\_ (Deputy)

GR-2901

#1522