

Locate well and acreage of irrigated land on plat.  
Scale: 2" = 1 Mile

STATE OF OREGON

County of Marion } ss.

I, Carl Stambach, being first duly sworn, do hereby certify that I have read the foregoing Registration Statement and that all of the items therein contained are true to the best of my knowledge and belief.

*Carl Stambach*  
(Signature of Registrant)

Subscribed and sworn to before me this 12 day of 19...

My commission expires ... (Notary Public)

(SEAL)

SEE PAGE GR-293-0 FOR CERTIFICATE OF REGISTRATION

STATE OF OREGON


County of Marion } ss.

This is to certify that the foregoing Registration Statement was received in the office of the State Engineer on the ... day of ... and has been duly recorded in said office in Book No. ... of Registration Statements on page ... of ...

Witness my hand this ... day of 19...

(State Engineer)

By (Deputy)

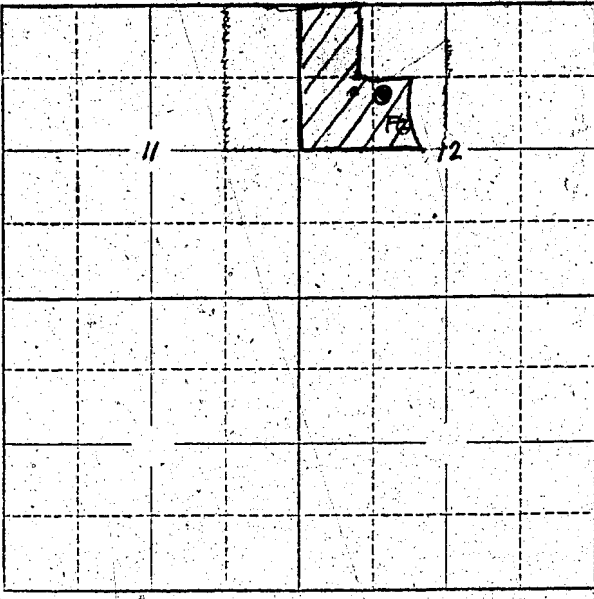

Locate well and acreage of irrigated land on plat. Scale: 2" = 1 Mile

STATE OF OREGON

County of Marion } ss.

I, Paul Stonebrook, being first duly sworn, do hereby certify that I have read the foregoing Registration Statement and that all of the items therein contained are true to the best of my knowledge and belief.

Paul Stonebrook (Signature of Registrant)

Subscribed and sworn to before me this ... day of ... 19...

My commission expires ... (Notary Public)

(SEAL)

SEE PAGE GR-293-0 FOR CERTIFICATE OF REGISTRATION

STATE OF OREGON

County of Marion } ss.

This is to certify that the foregoing Registration Statement was received in the office of the State Engineer on ... and has been duly recorded in said office in Book No. ... Registration Statements on page ... and the water completely applied to benefit ...

Witness my hand this ... day of ... 19...

(State Engineer)

By ... (Deputy)



