


Township 6S Range 2W, W.M.
North

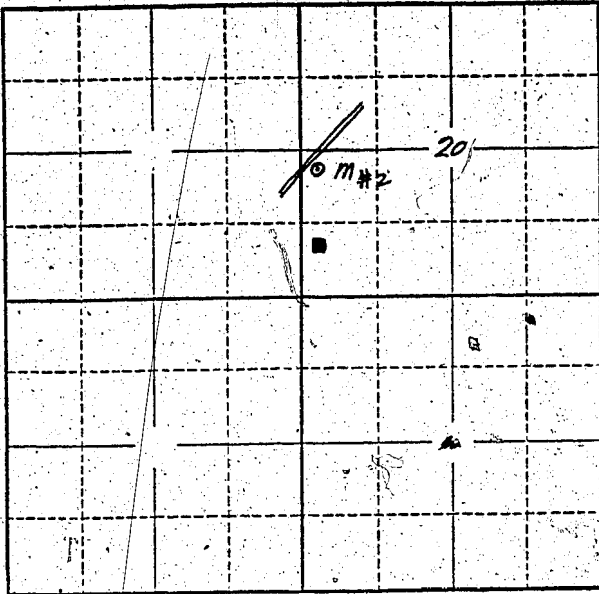

Locate well and acreage of irrigated land on plat.
Scale: 2" = 1 Mile

STATE OF OREGON

County of Marion } ss.

I, _____, being first duly sworn, do hereby certify that I have read the foregoing Registration Statement and that all of the items therein contained are true to the best of my knowledge and belief.

[Signature]
(Signature of Registrant)

Subscribed and sworn to before me this 30 day of July, 1958

My commission expires Nov. 23, 1958
[Signature]
(Notary Public)

(SEAL)

CERTIFICATE OF REGISTRATION

STATE OF OREGON } ss.
County of Marion

This is to certify that the foregoing Registration Statement was received in the office of the State Engineer on the 30th day of July, 1958, at 10:30 o'clock A.M. and has been duly recorded in said office in Book No. 12 of Registration Statements on page GR-2920

Witness my hand this 25th day of May, 1959
[Signature]
(State Engineer)

\$15.00

By _____
(Deputy)