


North

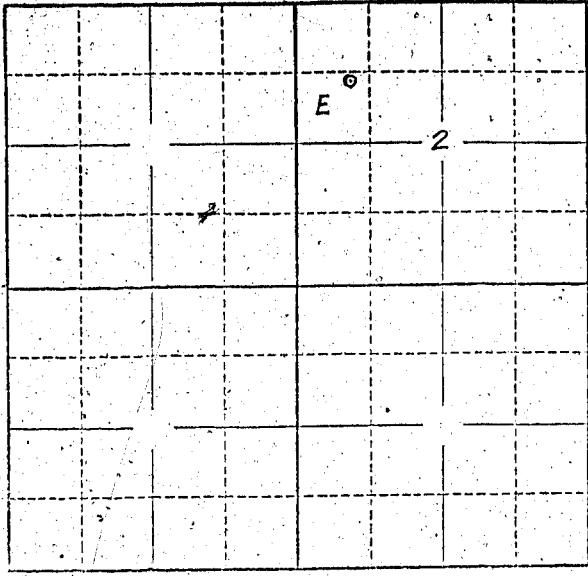

Locate well and acreage of irrigated land on plat.
Scale: 2" = 1 Mile.

STATE OF OREGON

County of _____ } ss.

I, _____, being first duly sworn, do hereby certify that I have read the foregoing Registration Statement and that all of the items therein contained are true to the best of my knowledge and belief.

Mabel H. Canfield
(Signature of Registrant)

Subscribed and sworn to before me this 17 day of September, 1957

My commission expires 6-6-61

[Signature]
(Notary Public)

(SEAL)

CERTIFICATE OF REGISTRATION

STATE OF OREGON

County of Marion } ss.

This is to certify that the foregoing Registration Statement was received in the office of the State Engineer on the 12th day of December, 1956, at 9⁰⁰ o'clock A. M. and has been duly recorded in said office in Book No. 11 of Registration Statements on page GR-2436

~~Construction shall be completed by _____ and the water completed by _____~~
~~benefit there by _____~~

Witness my hand this 16th day of March, 1959.

[Signature]
(State Engineer)

\$16.50

By _____ (Deputy)