


Township 1 S Range 1 E, W.M.  
North

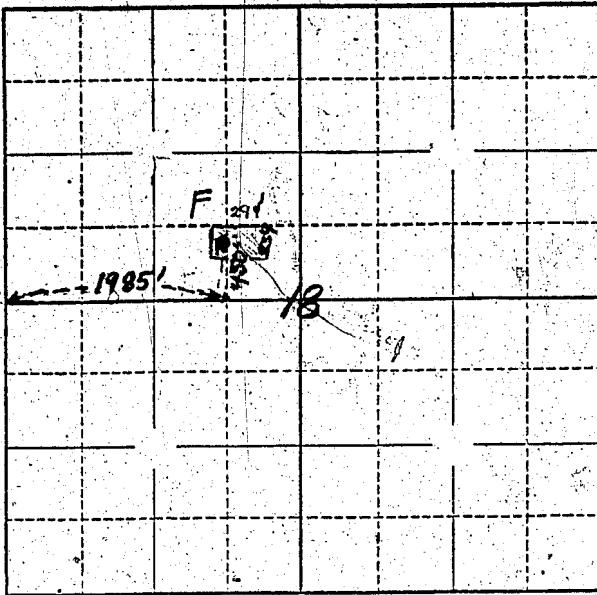

Well located in the SE 1/4 of NW 1/4 of Section 18, T1S R1E W.M. At a point which is east 1985 ft. and North 450 ft. from the west 1/4 corne of said section 18

W. 1/4 corne

Locate well and acreage of irrigated land on plat.

Scale: 2" = 1 Mile

STATE OF OREGON

County of Multnomah } ss.

I, Lena H. Gill, being first duly sworn, do hereby certify that I have read the foregoing Registration Statement and that all of the items therein contained are true to the best of my knowledge and belief.

Lena H. Gill  
(Signature of Registrant)

Subscribed and sworn to before me this 28 day of June, 1958  
2/28/60

My commission expires \_\_\_\_\_  
(Notary Public)

(SEAL)

**CERTIFICATE OF REGISTRATION**

STATE OF OREGON } ss.  
County of Marion

This is to certify that the foregoing Registration Statement was received in the office of the State Engineer on the 30th day of July, 1958, at 8:00 o'clock A.M. and has been duly recorded in my office in Book No. 12 of Registration Statements on page GR-2927

Witness my hand this 25th day of May, 1959

Leuris A. Stanley  
(State Engineer)

By \_\_\_\_\_  
(Deputy)

# 15.00