


Township 6S Range 3W, W.M.  
North

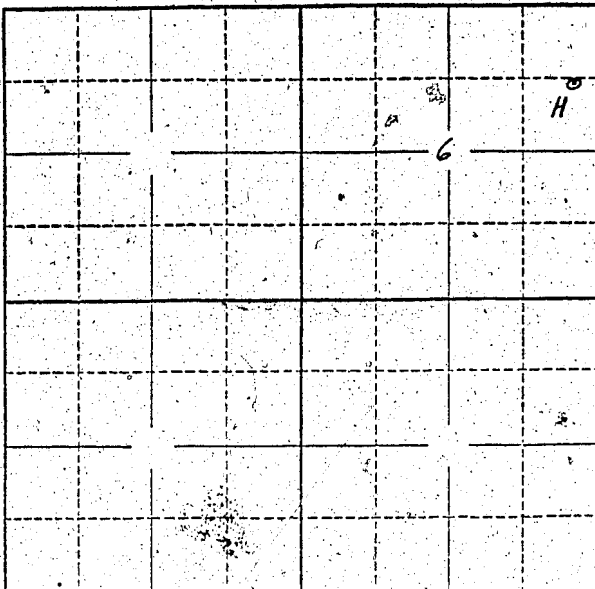

Locate well and acreage of irrigated land on plat.  
Scale: 2" = 1 Mile

STATE OF OREGON

County of Yamhill

ss.

WE, X Rauben Reist & Hilda Reist, being first duly sworn, do hereby certify that I have read the foregoing Registration Statement and that all of the items therein contained are true to the best of our ~~own~~ knowledge and belief.

X Rauben Reist  
Hilda Reist

(Signature of Registrant)

Subscribed and sworn to before me this 29 day of July, 19 58

My commission expires My Commission Expires April 19, 1960

George Dan Oakes  
(Notary Public)

(SEAL)

### CERTIFICATE OF REGISTRATION

STATE OF OREGON

County of Marion

ss.

This is to certify that the foregoing Registration Statement was received in the office of the State Engineer on the 30<sup>th</sup> day of July, 19 58, at 8:00 o'clock A. M. and has been duly recorded in said office in Book No. 12 of Registration Statements on page GR-2936

~~Construction shall be completed by October 19, 1958 and the water completely applied to beneficial use by October 19, 1958~~

Witness my hand this 25<sup>th</sup> day of May, 19 59

Lewis J. Stanley  
(State Engineer)

By \_\_\_\_\_

(Deputy)

\$ 15.00

GR-2936