


North

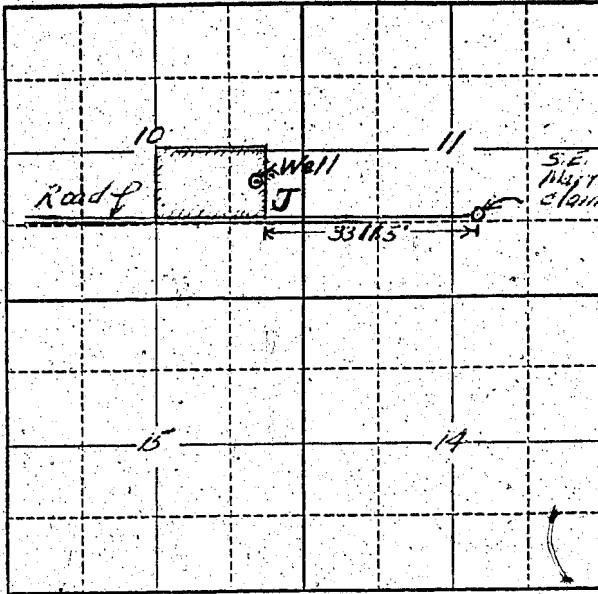

Locate well and acreage of irrigated land on plat.

Scale: 2" = 1 Mile

STATE OF OREGON

County of Polk

ss.

I, C. Parker Gies & Loeta J. Gies, being first duly sworn, do hereby certify that I have read the foregoing Registration Statement and that all of the items therein contained are true to the best of my knowledge and belief.

C. Parker Gies
Loeta J. Gies
 (Signature of Registrant)

Subscribed and sworn to before me this _____ day of July, 19 58.

My commission expires 12-18-58

(Notary Public)

(SEAL)

CERTIFICATE OF REGISTRATION

STATE OF OREGON

County of Marion

ss.

This is to certify that the foregoing Registration Statement was received in the office of the State Engineer on the 30 day of July, 19 58, at 8:00 o'clock P.M. and has been duly recorded in said office in Book No. 12 of Registration Statements on page GR 2937

Witness my hand this 25th day of May, 19 59

Lewis A. Stanley
 (State Engineer)

By _____ (Deputy)

\$19.50