


North

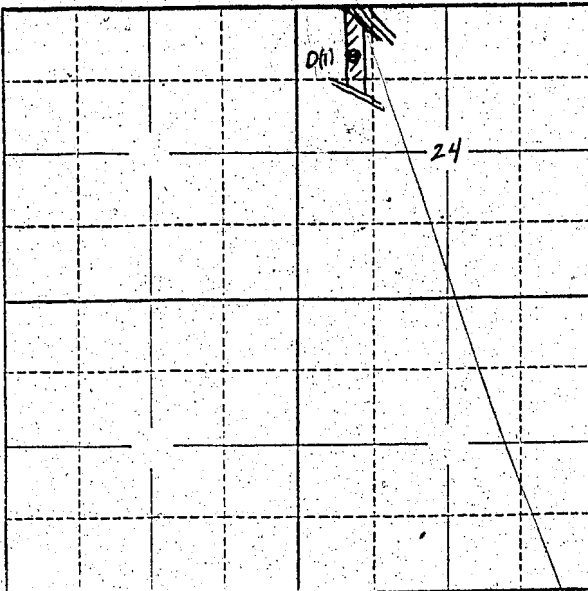

Locate well and acreage of irrigated land on plat.

Scale: 2" = 1 Mile

STATE OF OREGON

County of Linn } ss.

I, Andy and Annabella Hatzendorf, being first duly sworn, do hereby certify that I have read the foregoing Registration Statement and that all of the items therein contained are true to the best of my knowledge and belief.

Annabella Hatzendorf
Andy Hatzendorf
(Signature of Registrant)

Subscribed and sworn to before me this 15th day of December, 1956

My commission expires July 22 - 1959 J. Lewis Hucks
(Notary Public)

(SEAL)

CERTIFICATE OF REGISTRATION

STATE OF OREGON } ss.
County of Marion

This is to certify that the foregoing Registration Statement was received in the office of the State Engineer on the 7th day of December, 1956, at 8 o'clock A. M. and has been duly recorded in said office in Book No. 2 of Registration Statements on page GR-295-C

~~Construction work completed by xxxxxxxxxx and the water completely applied to xxxxxxxxxx~~

Witness my hand this 15th day of January, 1957
Lewis A. Stanley
(State Engineer)

By _____ (Deputy)
GR-295 C