


North

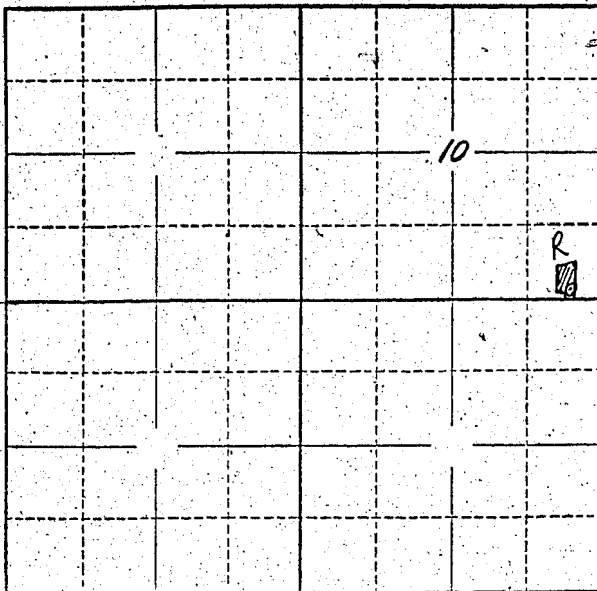

Locate well and acreage of irrigated land on plat.

Scale: 2" = 1 Mile

STATE OF OREGON

County of BENTON } ss.

I, George Neuman, being first duly sworn, do hereby certify that I have read the foregoing Registration Statement and that all of the items therein contained are true to the best of my knowledge and belief.

George Neuman
(Signature of Registrant)

Subscribed and sworn to before me this 28th day of July, 1958

Allen L. Tatum
(Notary Public)

My commission expires _____

NOTARY PUBLIC FOR OREGON

(SEAL) My Commission Expires Jan. 28, 1961

CERTIFICATE OF REGISTRATION

STATE OF OREGON } ss.
County of Marion

This is to certify that the foregoing Registration Statement was received in the office of the State Engineer on the 30 day of July, 1958, at 8:00 o'clock A. M. and has been duly recorded in said office in Book No. 12 of Registration Statements on page GR 2948

Witness my hand this 25th day of May, 1959

Lewis A. Stanley
(State Engineer)

By _____ (Deputy)

\$15.00