


North

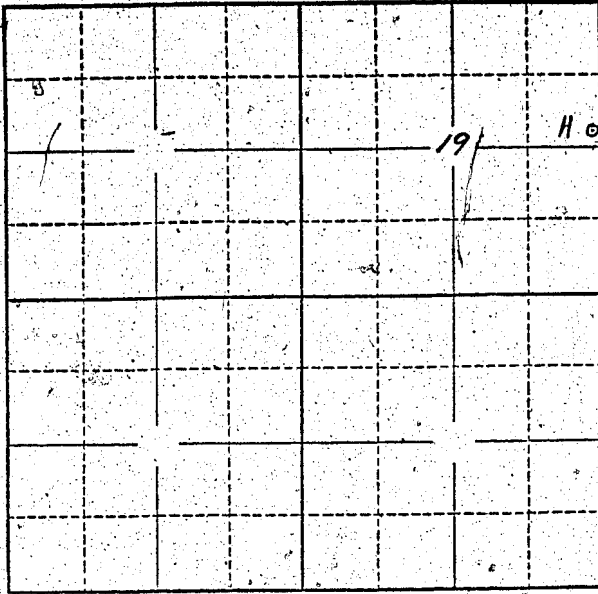

Locate well and acreage of irrigated land on plat.

Scale: 2" = 1 Mile

STATE OF OREGON

County of .....

} ss.

I, ....., being first duly sworn, do hereby certify that I have read the foregoing Registration Statement and that all of the items therein contained are true to the best of my knowledge and belief.

*H. A. ...*  
(Signature of Registrant)

Subscribed and sworn to before me this 22<sup>nd</sup> day of July, 1958.

My commission expires September 11, 1960

*Patricia A. ...*  
(Notary Public)

(SEAL)

**CERTIFICATE OF REGISTRATION**

STATE OF OREGON

County of Marion

} ss.

This is to certify that the foregoing Registration Statement was received in the office of the State Engineer on the 30<sup>th</sup> day of July, 1958, at 9<sup>00</sup> o'clock A M. and has been duly recorded in said office in Book No. 12 of Registration Statements on page GR-2954

Witness my hand this 25<sup>th</sup> day of May, 1959.

*Lewis A. Stanley*  
(State Engineer)

\$ 30.50

By ..... (Deputy)