Township 6 S Range 1 E, W.M.

North

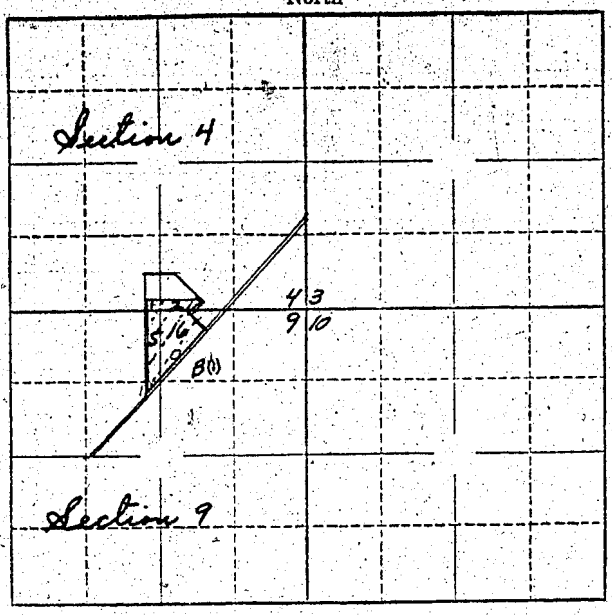

Locate well and acreage of irrigated land on plat.

Scale: 2" = 1 Mile

STATE OF OREGON
County of Marion } ss.

I, Orrin S. Rice, being first duly sworn, do hereby certify that I have read the foregoing Registration Statement and that all of the items therein contained are true to the best of my knowledge and belief.

Orrin S. Rice
(Signature of Registrant)

Subscribed and sworn to before me this 17 day of December, 19 56

My commission expires 9/27/58

Jeannie Baxter
(Notary Public)

(SEAL)

CERTIFICATE OF REGISTRATION

STATE OF OREGON
County of Marion } ss.

This is to certify that the foregoing Registration Statement was received in the office of the State Engineer on the 17th day of December, 19 56, at 9:30 o'clock A. M. and has been duly recorded in said office in Book No. 2 of Registration Statements on page GR-297-C

~~Certificate of Water Right Applied for~~ to ~~hereafter be issued by the State Engineer~~

Witness my hand this 15th day of January, 19 57

Lewis A. Stanley
(State Engineer)

By
(Deputy)

GR-297C