


(North Half of Block 94, Dallas Military Reservation)

Township 1 North Range 13 East, W.M.

North

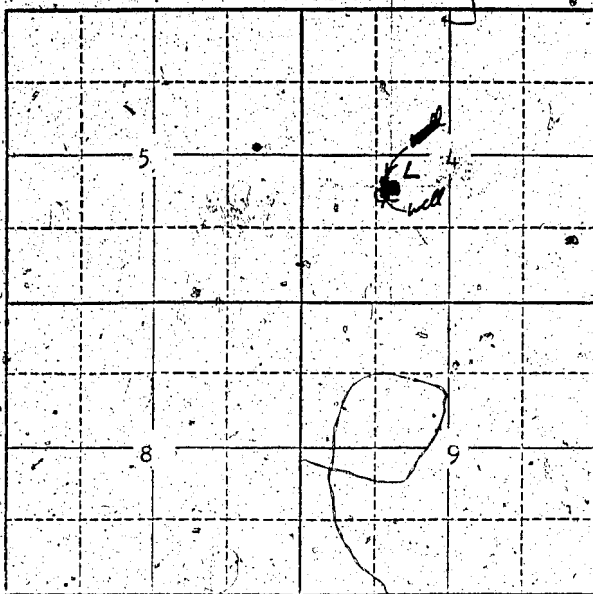

Well

Note: Shaded area is area to be irrigated.

Locate well and acreage of irrigated land on plat.

Scale: 2" = 1 Mile

STATE OF OREGON

Wasco

County of ~~Wasco~~

ss.

I, Don E. Kelsey, being first duly sworn, do hereby certify that I have read the foregoing Registration Statement and that all of the items therein contained are true to the best of my knowledge and belief.

*Don E. Kelsey*  
(Signature of Registrant)

Subscribed and sworn to before me this 28th day of July, 1958.

My commission expires January 15, 1962.

*Ronald E. Hensley*  
(Notary Public)

(SEAL)

CERTIFICATE OF REGISTRATION

STATE OF OREGON

ss.

County of Marion

This is to certify that the foregoing Registration Statement was received in the office of the State Engineer on the 30 day of July, 1958, at 11:30 o'clock A.M. and has been duly recorded in said office in Book No. 12 of Registration Statements on page GR 2959


Witness my hand this 25th day of May, 1959.

*Lewis A. Stanley*  
(State Engineer)

By

(Deputy)

GR-2959

\$15.00