


Township 2 S Range 38 E, W.M.  
North

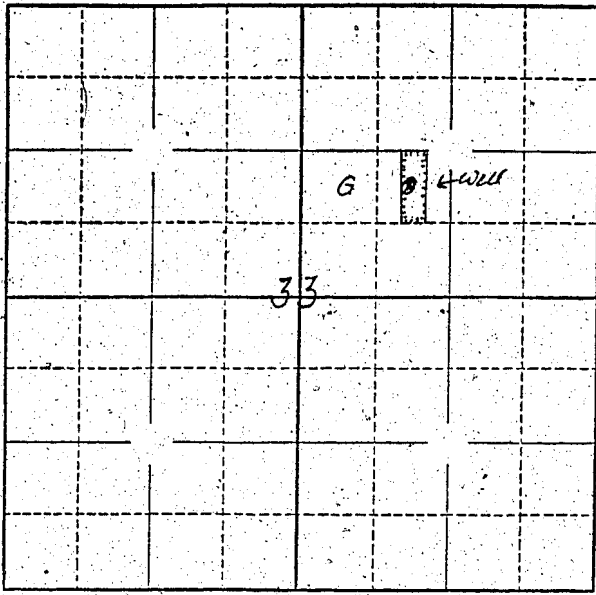

Well located 38 rods north of south end of tract as described and 2 rods east of the west side.

Locate well and acreage of irrigated land on plat.  
Scale: 1" = 1 Mile  
4" = .

STATE OF OREGON }  
County of Union } ss.

I, Robert J. Chandler, being first duly sworn, do hereby certify that I have read the foregoing Registration Statement and that all of the items therein contained are true to the best of my knowledge and belief.

Robert J. Chandler  
(Signature of Registrant)

Subscribed and sworn to before me this 29th day of July, 1958

My commission expires July 22, 1959

By: [Signature]  
(Notary Public)

(SEAL)

**CERTIFICATE OF REGISTRATION**

STATE OF OREGON }  
County of Marion } ss.

This is to certify that the foregoing Registration Statement was received in the office of the State Engineer on the 30 day of July, 1958, at 11:30 o'clock A.M. and has been duly recorded in said office in Book No. 12 of Registration Statements on page GR-2960

Witness my hand this 25th day of May, 1959

[Signature]  
(State Engineer)

By \_\_\_\_\_  
(Deputy)

\$15.00