


North

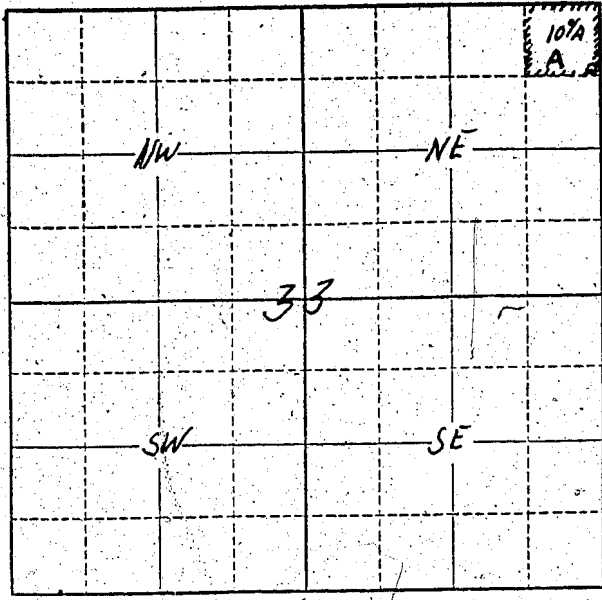

Well Location
645 feet South
+ 15 feet West
of NE Corner of
Sec 33.

Locate well and acreage of irrigated land on plat.

Scale: $\frac{1}{4}$ " = 1 Mile

STATE OF OREGON

County of Umatilla } ss.

I, ROBERT L. KLOVE, being first duly sworn, do hereby certify that I have read the foregoing Registration Statement and that all of the items therein contained are true to the best of my knowledge and belief.

Robert L. Klove
(Signature of Registrant)

Subscribed and sworn to before me this 25th day of July, 1958

My commission expires Feb. 24, 1959

Larry L. Jones
(Notary Public)

(SEAL)

CERTIFICATE OF REGISTRATION

STATE OF OREGON

County of Marion } ss.

This is to certify that the foregoing Registration Statement was received in the office of the State Engineer on the 30 day of July, 1958 at 11:30 o'clock A.M. and has been duly recorded in said office in Book No. 13 of Registration Statements on page GR 2963

Witness my hand this 2nd day of June, 1959

Lewis A. Stanley
(State Engineer)

By _____ (Deputy)

\$15.00