


Township 6N Range 35E, W.M.

North

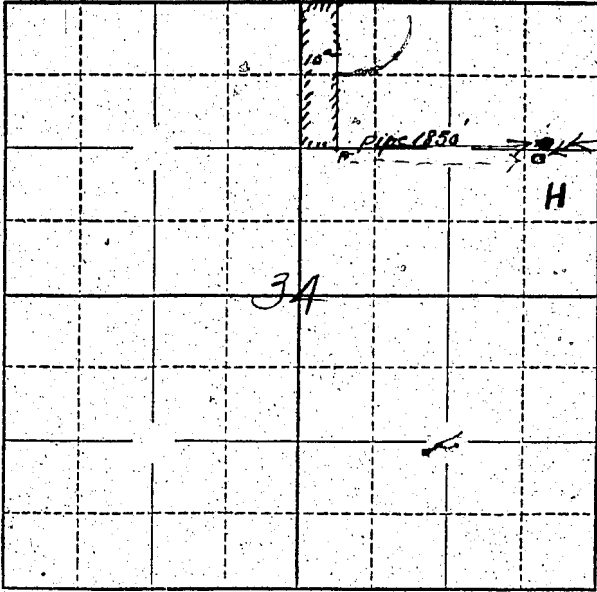

Well Located
 470' W. from a px
 4' S. from S.E. cor of
 NE 40' NE 1/4 sec 34
 Tp. 6N R. 35E W.M.

Locate well and acreage of irrigated land on plat.

Scale: 2" = 1 Mile
4" = 1 Mile

STATE OF OREGON

County of Umatilla } ss.

I, Jessie Reese, being first duly sworn, do hereby certify that I have read the foregoing Registration Statement and that all of the items therein contained are true to the best of my knowledge and belief.

Jessie Reese
(Signature of Registrant)

Subscribed and sworn to before me this 25th day of July, 1958

My commission expires aug 5, 1960

[Signature]
(Notary Public)

(SEAL)

CERTIFICATE OF REGISTRATION

STATE OF OREGON } ss.
County of Marion

This is to certify that the foregoing Registration Statement was received in the office of the State Engineer on the 30 day of July, 1958, at 11:30 o'clock A. M. and has been duly recorded in said office in Book No. 13 of Registration Statements on page GR-2970

Witness my hand this 2nd day of June, 1959

Lewis A. Stanley
(State Engineer)

By _____ (Deputy)

\$15.00