


Township 17 S Range 1 W W.M.
North

38 acres

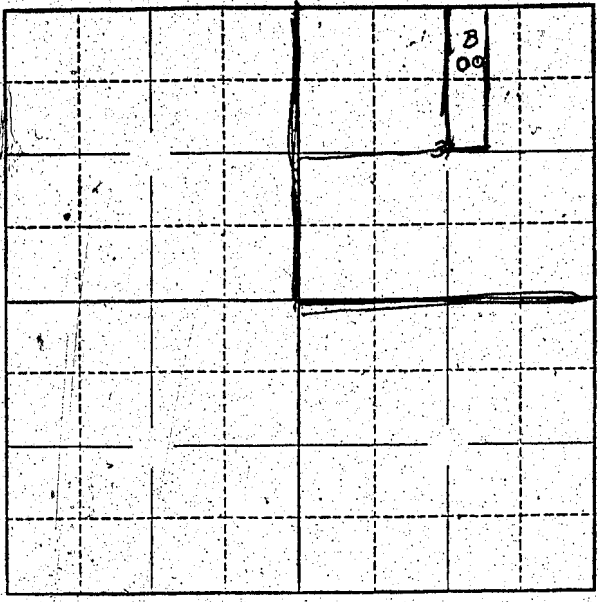

Locate well and acreage of irrigated land on plat.
Scale: 2" = 1 Mile

STATE OF OREGON

County of Lane } ss.

I, Guy MATHEWS, being first duly sworn, do hereby certify that I have read the foregoing Registration Statement and that all of the items therein contained are true to the best of my knowledge and belief.

Guy Mathews
(Signature of Registrant)

Subscribed and sworn to before me this 10th day of July, 1957

My commission expires _____

Harold M. [unclear]
(Notary Public)

(SEAL) NOTARY PUBLIC FOR OREGON
My Commission Expires Jan. 7, 1959

CERTIFICATE OF REGISTRATION

STATE OF OREGON

County of Marion } ss.

This is to certify that the foregoing Registration Statement was received in the office of the State Engineer on the 30th day of July, 1957, at 1:00 o'clock A.M. and has been duly recorded in said office in Book No. 17, of Registration Statements on page GR 4049

Witness my hand this 16th day of May, 1960

Lewis A. Stanley
(State Engineer)

By _____
(Deputy)

\$16.20