


Property can be easily located as 17650 S. W.

Old River Road, Oswego, Oregon

Tax lot 5 Section 14

Township 2 south Range 1 east, W.M.
North

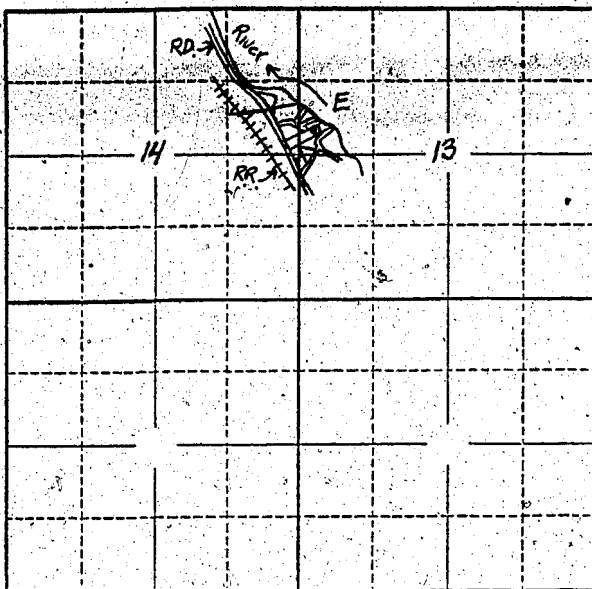

Locate well and acreage of irrigated land on plat.

Scale of 2 inches = 1 mile
Scale 1" equals 200 ft.

STATE OF OREGON

County of Multnomah

ss.

I, Guy E. Jaques, being first duly sworn, do hereby certify that I have read the foregoing Registration Statement and that all of the items therein contained are true to the best of my knowledge and belief.

Guy E. Jaques
(Signature of Registrant)

Subscribed and sworn to before me this 28th day of July, 1958.

My commission expires August 31, 1958.

Max J. Lockman
(Notary Public)

(SEAL)

CERTIFICATE OF REGISTRATION

STATE OF OREGON

County of Marion

ss.

This is to certify that the foregoing Registration Statement was received in the office of the State Engineer on the 30th day of July, 1958, at 8:00 o'clock A.M. and has been duly recorded in said office in Book No. 16 of Registration Statements on page GR-3892

Witness my hand this 15th day of February, 1960

Stuart A. Stanley
(State Engineer)

By _____ (Deputy)

\$15.00

GR 3892