


170 of  
old Perry Subdivision

Township 37 S Range 2 W W.M.  
North

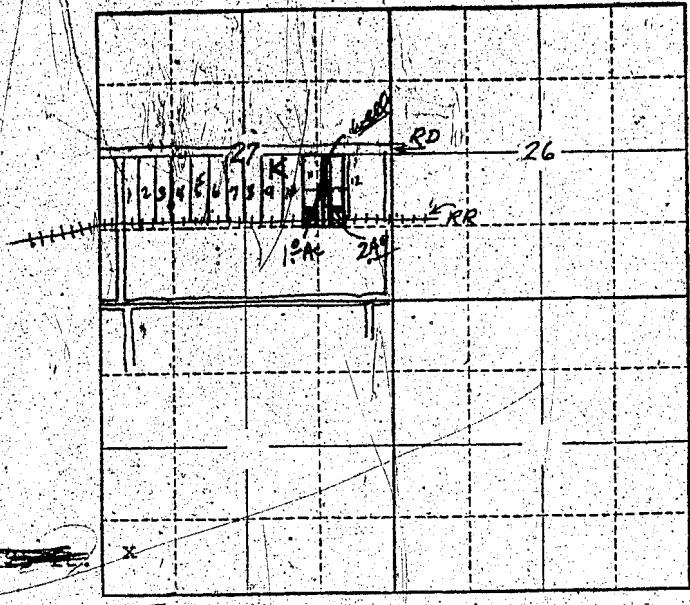

321-18  
Locate well and acreage of irrigated land on plat.  
Scale: 2" = 1 Mile

STATE OF OREGON  
County of Jackson } ss.

I, Walter L. Wilson, being first duly sworn, do hereby certify that I have read the foregoing Registration Statement and that all of the items therein contained are true to the best of my knowledge and belief.

Walter L. Wilson  
(Signature of Registrant)

Subscribed and sworn to before me this 28 day of July, 1958

My commission expires Sept. 24, 1958

[Signature]  
(Notary Public)

(SEAL)

### CERTIFICATE OF REGISTRATION

STATE OF OREGON } ss.  
County of Marion

This is to certify that the foregoing Registration Statement was received in the office of the State Engineer on the 30th day of July, 1958 at 8:00 o'clock A. M. and has been duly recorded in said office in Book No. 17 of Registration Statements on page 4079

Witness my hand this 16th day of May, 1960

LEWIS A. STANLEY  
(State Engineer)

By Max F. Rogers  
(Deputy)

\$15.00

GR. 4079