


North

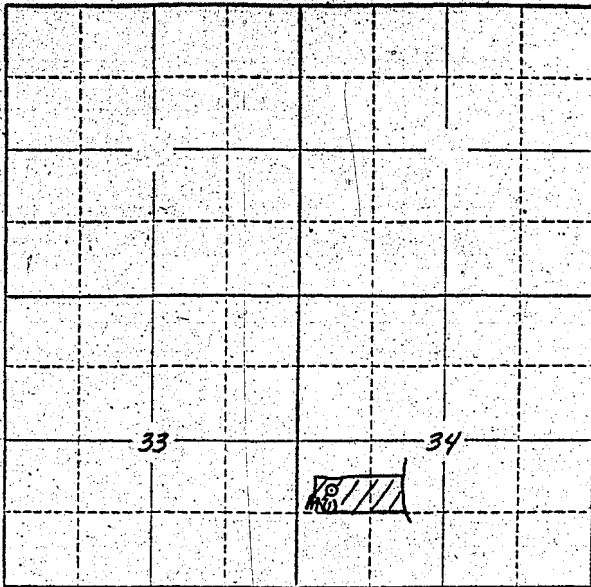

Locate well and acreage of irrigated land on plat.

Scale: 2" = 1 Mile

STATE OF OREGON

County of Linn } ss.

I, Maude Hentze, being first duly sworn, do hereby certify that I have read the foregoing Registration Statement and that all of the items therein contained are true to the best of my knowledge and belief.

Maude Hentze
(Signature of Registrant)

Subscribed and sworn to before me this 18th day of December, 19 56

My commission expires April 11, 1960
Felma Hubert
(Notary Public)

(SEAL)

SEE PAGE GR-301-K FOR
CERTIFICATE OF REGISTRATION

STATE OF OREGON } ss.
County of Marion

~~This is to certify that the foregoing Registration Statement was received in the office of the State Engineer on the x-x-x-x day of x-x-x-x x-x-x-x 19-x-x at x-x-x-x of clock x-x-x-x. It has been duly recorded in said office in Book No. x-x-x-x of Registration Statements on page x-x-x-x-x-x-x-x. Construction shall be completed by x-x-x-x-x-x-x-x 19-x-x, and the water completely applied to beneficial use by x-x-x-x-x-x-x-x 19-x-x.~~

Witness my hand this day of, 19.....

(State Engineer)

By
(Deputy)

