


Township 37 So. Range 2 W. W.M.
North

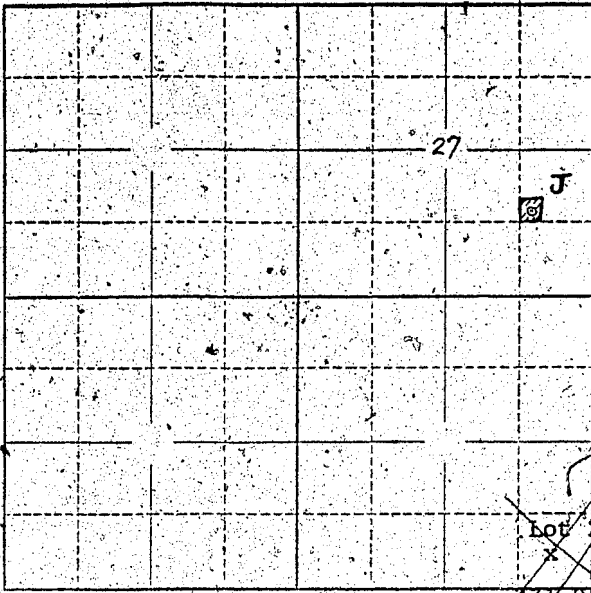

Locate well and acreage of irrigated land on plat

Scale: 2" = 1 Mile

STATE OF OREGON

County of Jackson

ss.

I, Walter L. Wilson, being first duly sworn, do hereby certify that I have read the foregoing Registration Statement and that all of the items therein contained are true to the best of my knowledge and belief.

Walter L. Wilson
(Signature of Registrant)

Subscribed and sworn to before me this 28 day of July, 1958

My commission expires Sept. 24, 1958

Ernest L. ...
(Notary Public)

(SEAL)

CERTIFICATE OF REGISTRATION

STATE OF OREGON

County of Marion

ss.

This is to certify that the foregoing Registration Statement was received in the office of the State Engineer on the 30 day of July, 1958, at ... o'clock ... M. and has been duly recorded in said office in Book No. 17 of Registration Statements on page GR-4080

~~Construction shall be completed by ... and the water completely available for beneficial use by ...~~

Witness my hand this 16 day of May, 1960

LEWIS A. STANLEY
(State Engineer)

By *Max F. Rogers*
Max F. Rogers (Deputy)

GR-4080

#15.00