


North

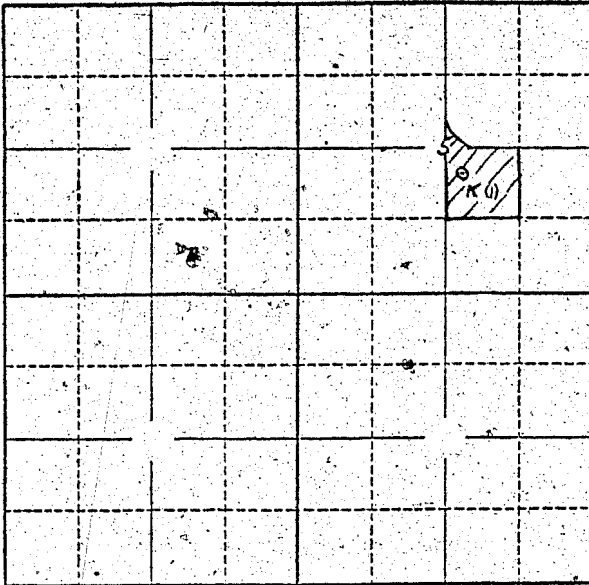

Locate well and acreage of irrigated land on plat.

Scale: 2" = 1 Mile

STATE OF OREGON

County of Linn

ss.

I, George N. and Hazel C. Chandler, being first duly sworn, do hereby certify that I have read the foregoing Registration Statement and that all of the items therein contained are true to the best of my knowledge and belief.

George N. Chandler
Hazel C. Chandler
(Signature of Registrant)

Subscribed and sworn to before me this 27th day of December, 1957

My commission expires

R. M. Russell, Jr.
G. E. Magart, Jr.
(Notary Public)

(SEAL)

CERTIFICATE OF REGISTRATION

STATE OF OREGON

County of Marion

ss.

This is to certify that the foregoing Registration Statement was received in the office of the State Engineer on the 28th day of December, 1955, at 10 o'clock A.M. and has been duly recorded in said office in Book No. 2 of Registration Statements on page GR-304 C

Construction work to be completed by X-X-X-X-X-X-X-X-X-X-X-X-X-X and the water completely applied to beneficial use by X-X-X-X-X-X-X-X-X-X-X-X-X-X

Witness my hand this 14th day of March, 1957

Lewis A. Stanley
(State Engineer)

By (Deputy)

GR-304C