


SEE ATTACHED MAP

Township 16S Range 3W W.M.
North

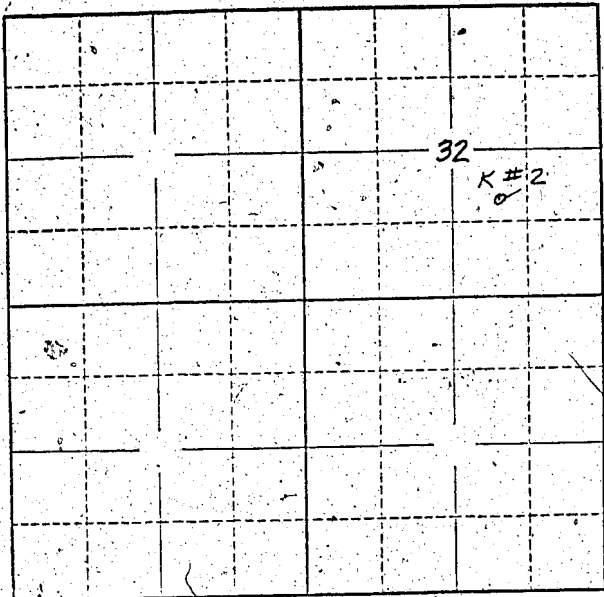

Locate well and acreage of irrigated land on plat.
Scale: 2" = 1 Mile.

STATE OF OREGON }
County of Lane } ss.

I, Leon H. Funke & his Flossie Funke being first duly sworn, do hereby certify that I have read the foregoing Registration Statement and that all of the items therein contained are true to the best of my knowledge and belief.

Leon H. Funke and Flossie Funke
(Signature of Registrant)

Subscribed and sworn to before me this 29th day of July, 1958

My commission expires May 14, 1960
(Notary Public)

(SEAL)

CERTIFICATE OF REGISTRATION

STATE OF OREGON }
County of Marion } ss.

This is to certify that the foregoing Registration Statement was received in the office of the State Engineer on the 30th day of July, 1958, at 9:00 o'clock A.M. and has been duly recorded in said office in Book No. 13 of Registration Statements on page GR 3001

Witness my hand this 2nd day of June, 1959

Lewis J. Stanley
(State Engineer)

By _____
(Deputy)

\$15.00