


Township 16S Range 3W, W.M.

North

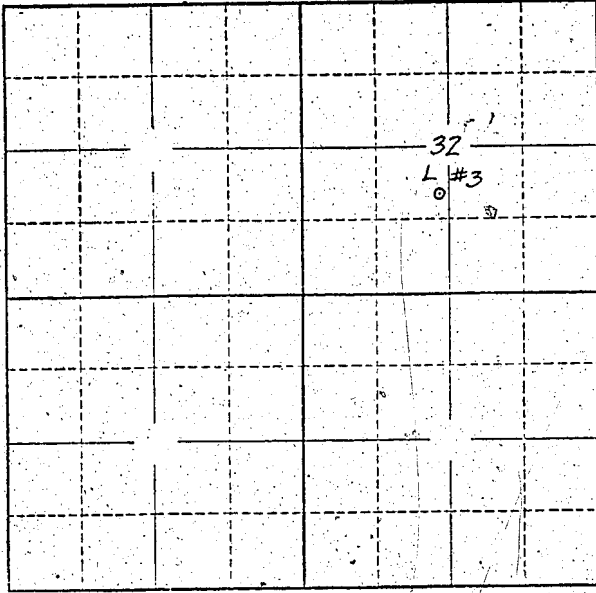

Locate well and acreage of irrigated land on plat.

Scale: 2" = 1 Mile

STATE OF OREGON

County of Grant } ss.

I, Leon H. Fenske and Thos. Fenske, being first duly sworn, do hereby certify that I have read the foregoing Registration Statement and that all of the items therein contained are true to the best of my knowledge and belief.

Leon H. Fenske and Thos. Fenske  
(Signature of Registrant)

Subscribed and sworn to before me this 24th day of July, 1958

My commission expires August 1959 (Notary Public)

(SEAL)

**CERTIFICATE OF REGISTRATION**

STATE OF OREGON } ss.  
County of Marion

This is to certify that the foregoing Registration Statement was received in the office of the State Engineer on the 30th day of July, 1958, at 9:00 o'clock A. M. and has been duly recorded in said office in Book No. 13 of Registration Statements on page GR-3002

Witness my hand this 2nd day of June, 1959

Lewis A. Stanley  
(State Engineer)

By \_\_\_\_\_ (Deputy)

\$1500