


Township 17S Range 3W W.M.
North

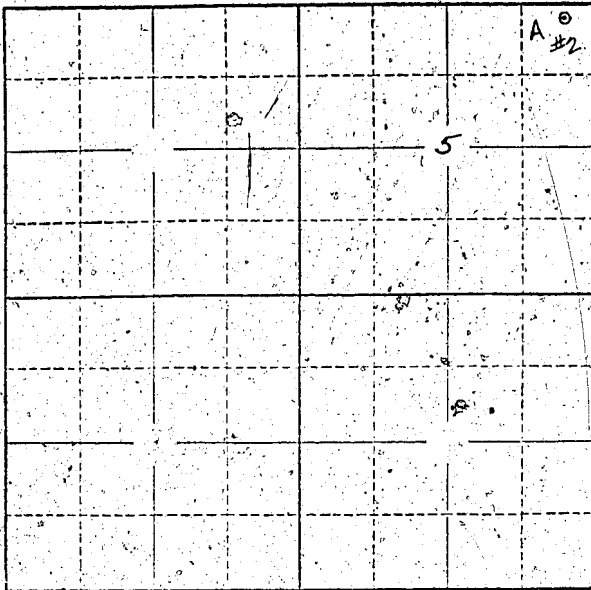

Locate well and acreage of irrigated land on plat.
Scale: 2" = 1 Mile

STATE OF OREGON

County of Lane ss.

I, Leon M. Runke and/or Flossie Runke, being first duly sworn, do hereby certify that I have read the foregoing Registration Statement and that all of the items therein contained are true to the best of my knowledge and belief.

Leon M. Runke and/or Flossie Runke
(Signature of Registrant)

Subscribed and sworn to before me this 27th day of July, 1958

My commission expires March 14, 1961
(Notary Public)

(SEAL)

CERTIFICATE OF REGISTRATION

STATE OF OREGON
County of Marion ss.

This is to certify that the foregoing Registration Statement was received in the office of the State Engineer on the 30th day of July, 1958 at 9:00 o'clock A.M. and has been duly recorded in said office in Book No. 13 of Registration Statements on page GR-3006

Witness my hand this 2nd day of June, 1959

Lewis A. Stanley
(State Engineer)

By _____ (Deputy)

\$15.00