


Water Right Map.

For Leon H. Funke Sec. 32 T. 16 S. R. 3 W.

GR 3230
3231
3232

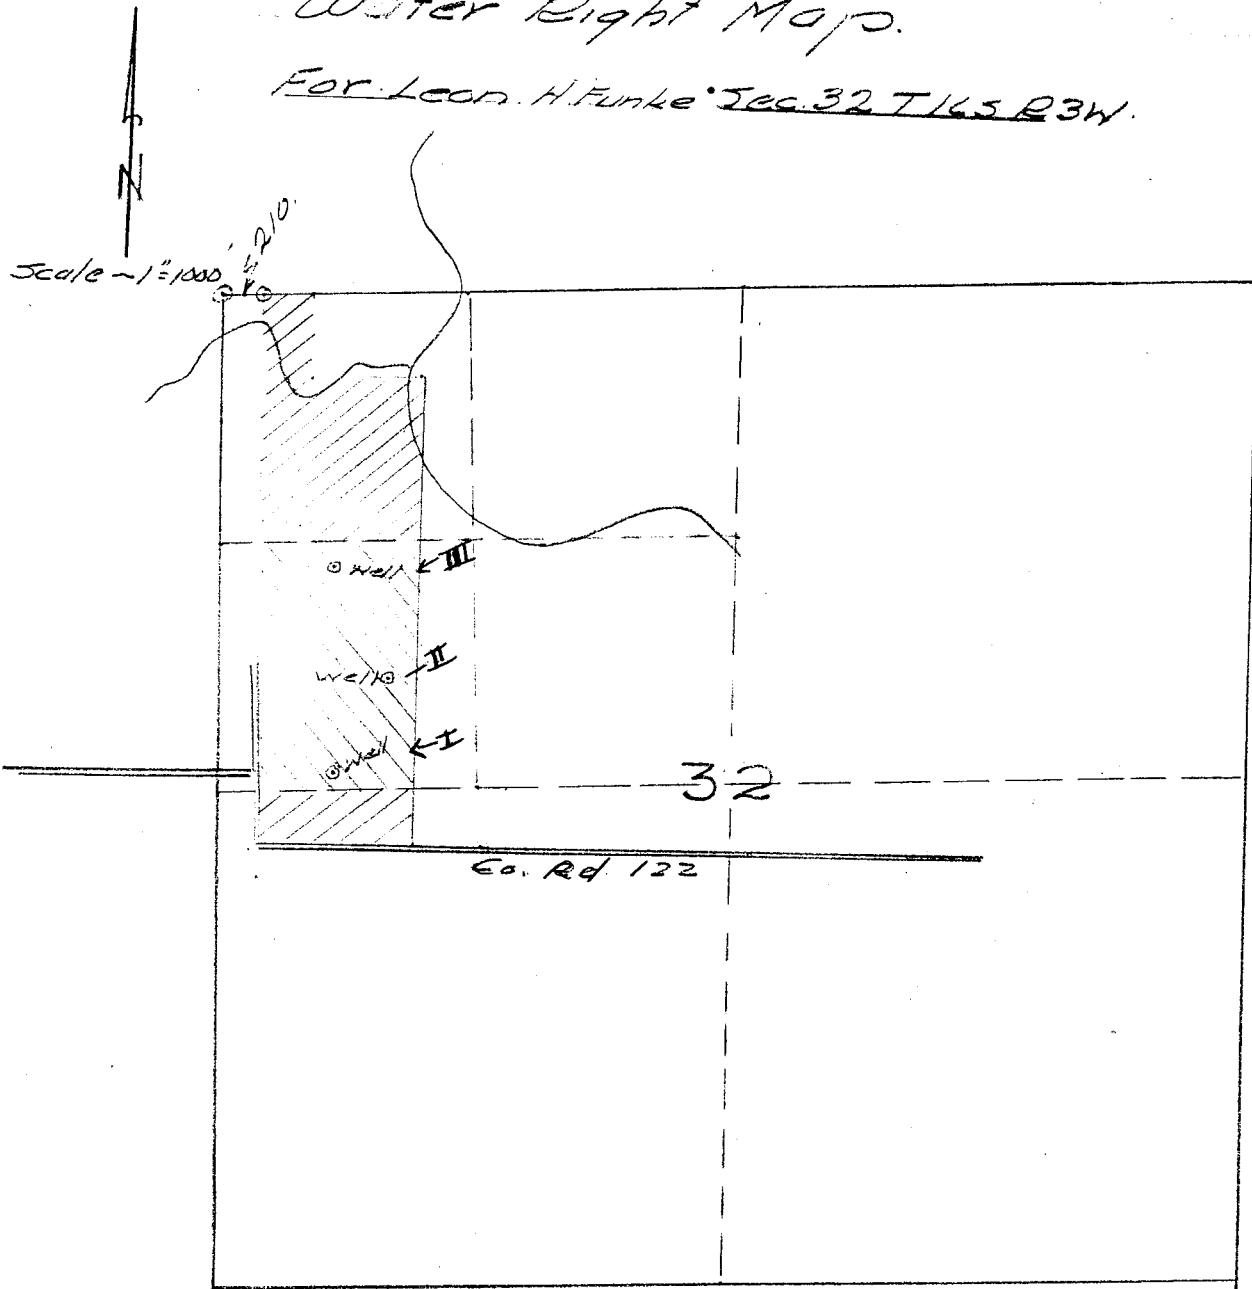

Well no - I S 2500' E 600' of N.W. Corner of Sec 32 T 16 S R 3 W.

Well no II S 2000' E 880' of N.W. Corner of Sec 32 T 16 S R 3 W

Well no III S 1400' E 600' of N.W. Corner of Sec 32 T 16 S R 3 W

19.68 Acres NW $\frac{1}{4}$ of NW $\frac{1}{4}$ of Sec 32 T 16 S R 3 W

26.1 Acres S.W. $\frac{1}{4}$ of N.W. $\frac{1}{4}$ of Sec 32 T 16 S R 3 W

5.5 Acres N.W. $\frac{1}{4}$ of S.W. $\frac{1}{4}$ of Sec 32 T 16 S R 3 W

George Smith