


North

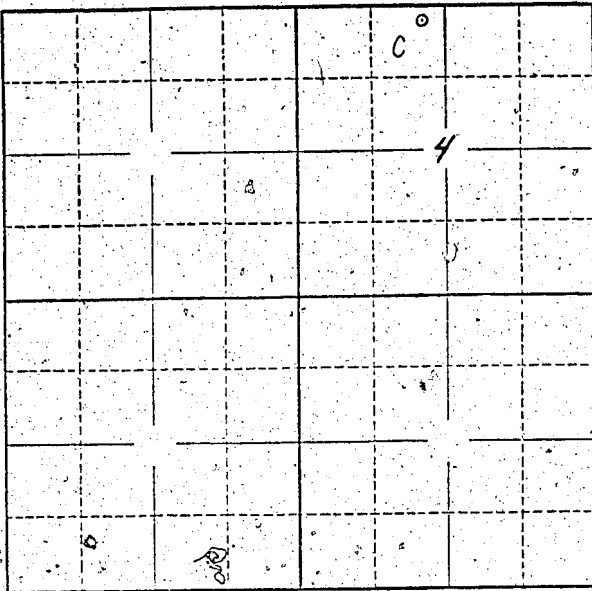

Locate well and acreage of irrigated land on plat.

Scale: 2" = 1 Mile

STATE OF OREGON

County of LINN

ss.

I, Roy and Ruth E. Snoderly, being first duly sworn, do hereby certify that I have read the foregoing Registration Statement and that all of the items therein contained are true to the best of my knowledge and belief.

Roy Snoderly
Ruth E. Snoderly
 (Signature of Registrant)

Subscribed and sworn to before me this 28th day of July, 1959

My commission expires Jan 11, 1959

(Notary Public)

(SEAL)

CERTIFICATE OF REGISTRATION

STATE OF OREGON

County of Marion

ss.

This is to certify that the foregoing Registration Statement was received in the office of the State Engineer on the 30th day of July, 1959, at 2:00 o'clock A.M. and has been duly recorded in said office in Book No. 13 of Registration Statements on page GR-3013

Witness my hand this 8th day of June, 1959

Walter A. Shirley
 (State Engineer)

By (Deputy)

\$15.00