


North

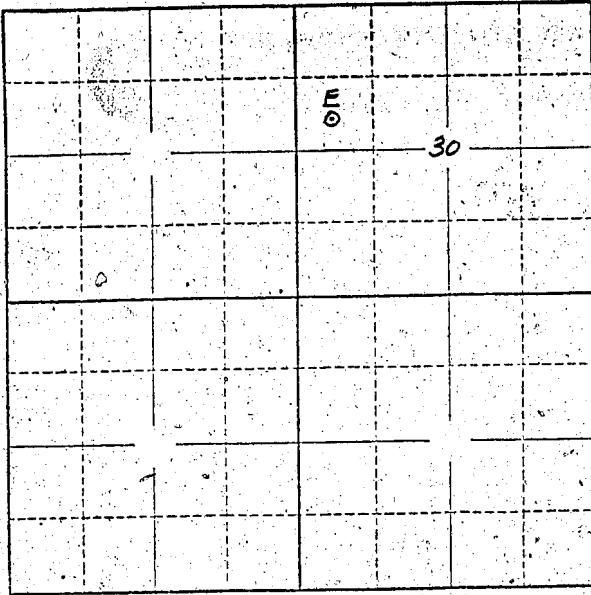

Locate well and acreage of irrigated land on plat.

Scale: 2" = 1 Mile

STATE OF OREGON

County of LINN

ss.

I, Nicholas and/or Olga B. Vandenberg, being first duly sworn, do hereby certify that I have read the foregoing Registration Statement and that all of the items therein contained are true to the best of my knowledge and belief.

*Nicholas Vandenberg*  
*Olga B. Vandenberg*  
(Signature of Registrant)

Subscribed and sworn to before me this 27<sup>th</sup> day of July, 1958

My commission expires My Commission Expires Mar 12, 1961

(Notary Public)

(SEAL)

CERTIFICATE OF REGISTRATION

STATE OF OREGON

County of Marion

ss.

This is to certify that the foregoing Registration Statement was received in the office of the State Engineer on the 30<sup>th</sup> day of July, 1958, at 6 o'clock P.M. and has been duly recorded in said office in Book No. 13 of Registration Statements on page GR 3017

Witness my hand this 8<sup>th</sup> day of June, 1959

(State Engineer)

By \_\_\_\_\_ (Deputy)

#1500