


Township 15 Range 3E W.M. SECT 36

North

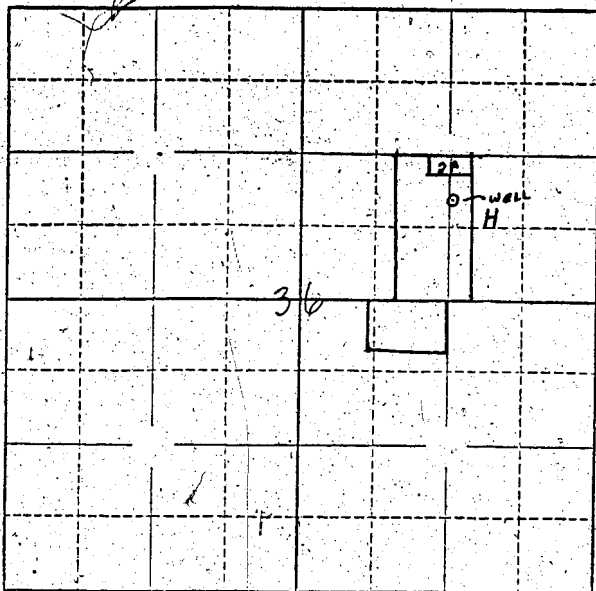

Locate well and acreage of irrigated land on plat.

Scale: = 1 Mile

4"

STATE OF OREGON

County of CLATSOP

ss.

I, ALBERT FINKNER, being first duly sworn, do hereby certify that I have read the foregoing Registration Statement and that all of the items therein contained are true to the best of my knowledge and belief.

Albert Finkner
(Signature of Registrant)

Subscribed and sworn to before me this 29th day of July, 1958.

My commission expires April 19, 1961

Albert Finkner
(Notary Public)

(SEAL)

CERTIFICATE OF REGISTRATION

STATE OF OREGON

County of Marion

ss.

This is to certify that the foregoing Registration Statement was received in the office of the State Engineer on the 30 day of July, 1958, at 8:00 o'clock A M. and has been duly recorded in said office in Book No. 13 of Registration Statements on page GR-3025

Witness my hand this 8th day of June, 1959

Lawrence Stanley
(State Engineer)

By _____
(Deputy)

\$15.00