


Township 75 Range 3W W.M.

North

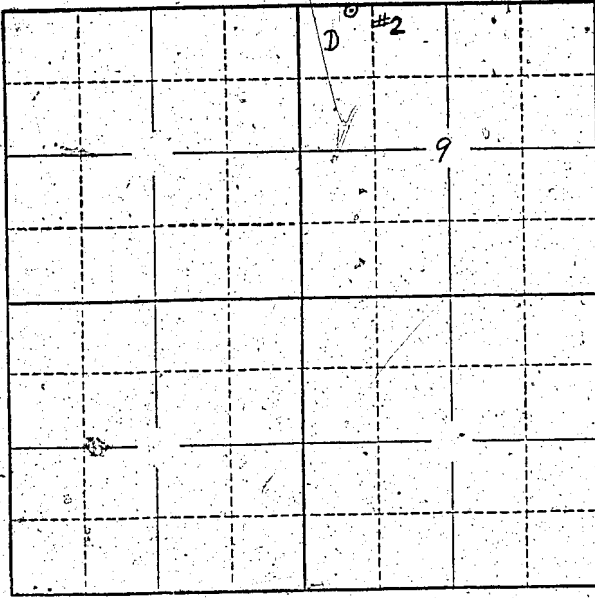

Locate well and acreage of irrigated land on plat.

Scale: 2" = 1 Mile

STATE OF OREGON

County of Tall

ss.

I, Billy J. Tower being first duly sworn, do hereby certify that I have read the foregoing Registration Statement and that all of the items therein contained are true to the best of my knowledge and belief.

Billy J. Tower  
(Signature of Registrant)

Subscribed and sworn to before me this 21st day of February, 1951

My commission expires July 16, 1961 Joseph G. Hact  
(Notary Public)

(SEAL)

**CERTIFICATE OF REGISTRATION**

STATE OF OREGON

County of Marion

ss.

This is to certify that the foregoing Registration Statement was received in the office of the State Engineer on the 31st day of July, 1951, at 2<sup>00</sup> o'clock P. M. and has been duly recorded in said office in Book No. 13 of Registration Statements on page GR-3031

Witness my hand this 8<sup>th</sup> day of June, 1959

Laura A. Stanley  
(State Engineer)

By \_\_\_\_\_  
(Deputy)

\$15.90