


North

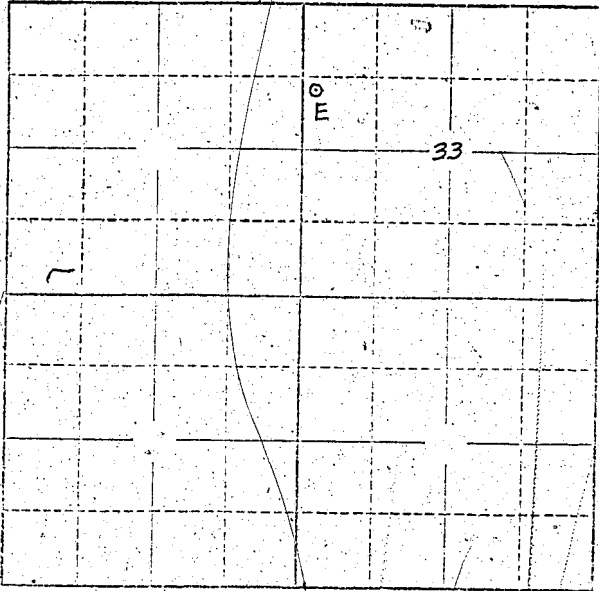

Locate well and acreage of irrigated land on plat.

Scale: 2" = 1 Mile

STATE OF OREGON

County of Linn } ss.

I, Rage Gibson, being first duly sworn, do hereby certify that I have read the foregoing Registration Statement and that all of the items therein contained are true to the best of my knowledge and belief.

Rage Gibson
(Signature of Registrant)

Subscribed and sworn to before me this 25th day of July, 1957

My commission expires April 11, 1960

Julia Blum
(Notary Public)

(SEAL)

CERTIFICATE OF REGISTRATION

STATE OF OREGON }
County of Marion } ss.

This is to certify that the foregoing Registration Statement was received in the office of the State Engineer on the 30th day of July, 1958, at 2:45 o'clock P. M. and has been duly recorded in said office in Book No. 13 of Registration Statements on page GR- 3038

~~Construction shall be completed by 1959 and the water completely applied to beneficial uses by 1959.~~

Witness my hand this 8th day of June, 1959

Lawrence A. Stanley
(State Engineer)

By _____ (Deputy)

7/15/55