


A290
NEIL GRIBSKOV PROPERTY
 SCALE 1" = 400

Prepared by the Office of H.G. Chickering Jr.
 Consulting Photogrammetrist Inc. Eugene,
 Oregon, from Vertical Aerial Photography
 Dated 1952. Map Compiled 3-5-58.



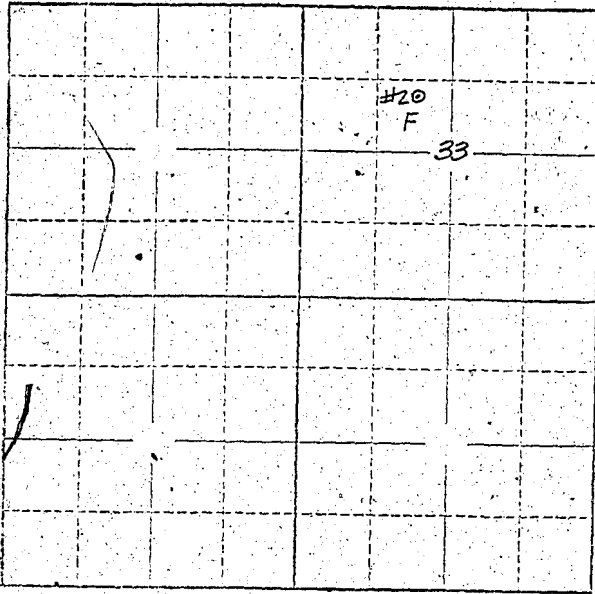

Locate well and acreage of irrigated land on plat. Scale: 2" = 1 Mile

STATE OF OREGON

County of Lane } ss.

I, Angie Gibbons, being first duly sworn, do hereby certify that I have read the foregoing Registration Statement and that all of the items therein contained are true to the best of my knowledge and belief.

Angie Gibbons (Signature of Registrant)

Subscribed and sworn to before me this 29th day of July, 1958.

My commission expires April 11, 1960.

W. L. Stuberth (Notary Public)

(SEAL)

CERTIFICATE OF REGISTRATION

STATE OF OREGON } ss. County of Marion

This is to certify that the foregoing Registration Statement was received in the office of the State Engineer on the 30th day of July, 1958, at 2:35 o'clock P.M. and has been duly recorded in said office in Book No. 13 of Registration Statements on page GR-3039

~~xy Construction shall be completed by 10/1/59 and the water completely supplied as provided for by 10/1/59 xy~~

Witness my hand this 8th day of June, 1959.

Flora A. Stanley (State Engineer)

By (Deputy)

\$15.00