


North

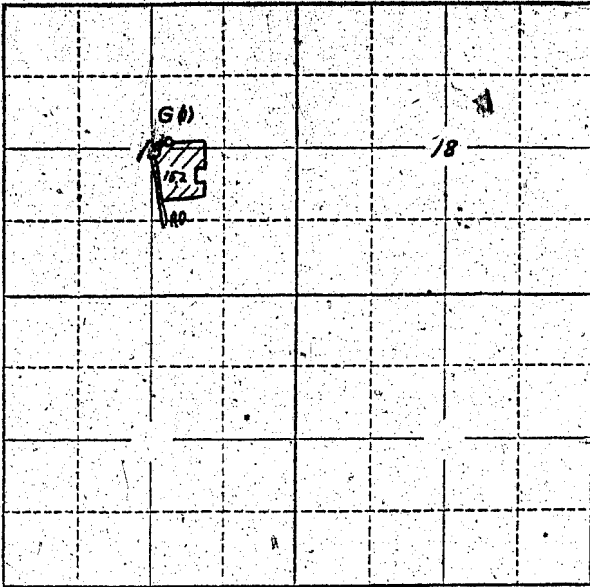

Locate well and acreage of irrigated land on plat.

Scale: 2" = 1.Mile

STATE OF OREGON

County of Linn

ss.

I, Marvin W. and Helen E. Fletcher being first duly sworn, do hereby certify that I have read the foregoing Registration Statement and that all of the items therein contained are true to the best of my knowledge and belief.

*Marvin W. Fletcher*  
*Helen E. Fletcher*  
 (Signature of Registrant)

Subscribed and sworn to before me this 3 day of Jan, 1957

My commission expires NOTARY PUBLIC FOR OREGON My Commission Expires May 2, 1959

*Clair D. Hillard*  
 (Notary Public)

(SEAL)

SEE PAGE GR-309 G FOR CERTIFICATE OF REGISTRATION

STATE OF OREGON

County of Marion

ss.

This is to certify that the foregoing Registration Statement was received in the office of the State Engineer on the 10th day of January 1957 and has been duly recorded in said office in Book No. of Registration Statement on page

Construction shall be completed by 1957 and the water completely applied to beneficial use by 1957

Witness my hand this 10th day of March 1957

(State Engineer)

By (Deputy)

