


Township 6S Range 2W W.M.  
North

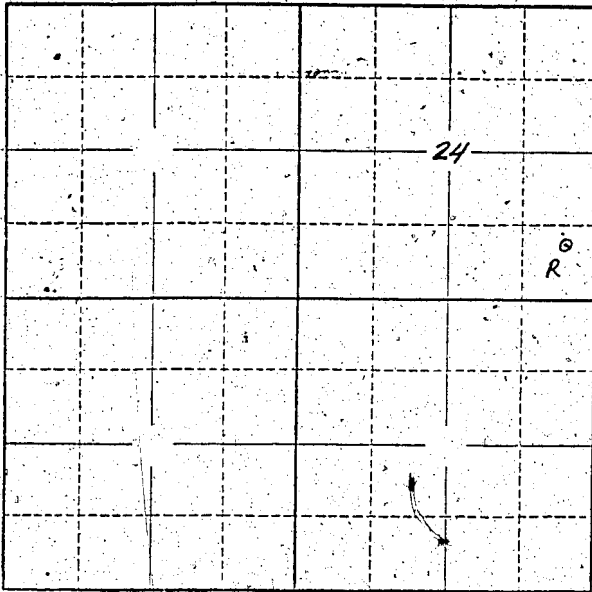

Locate well and acreage of irrigated land on plat.  
Scale: 2" = 1 Mile

STATE OF OREGON

County of Marion } ss.

I, \_\_\_\_\_, being first duly sworn, do hereby certify that I have read the foregoing Registration Statement and that all of the items therein contained are true to the best of my knowledge and belief.

[Signature]  
(Signature of Registrant)

Subscribed and sworn to before me this 27 day of July, 1958

My commission expires 1-22-1962  
[Signature]  
(Notary Public)

(SEAL)

**CERTIFICATE OF REGISTRATION**

STATE OF OREGON } ss.  
County of Marion

This is to certify that the foregoing Registration Statement was received in the office of the State Engineer on the 30th day of July, 1958, at 3:10 o'clock P. M. and has been duly recorded in said office in Book No. 13 of Registration Statements on page GR-3042

Witness my hand this 8th day of June, 1959

[Signature]  
(State Engineer)

By \_\_\_\_\_  
(Deputy)

\$15.00