Section 36

Township 26S Range 3W., W.M.

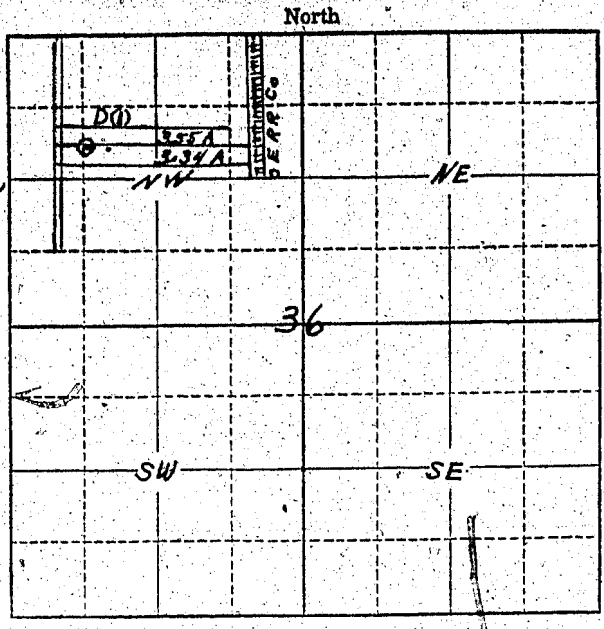

NW¼ of NW¼, Sec 36 6S R3W
Vol 355-P618
Vol(476-449) Contract

Locate well and acreage of irrigated land on plat.

Scale: 2" = 1 Mile

STATE OF OREGON
County of Marion } ss.

I, Lewis Mayers, being first duly sworn, do hereby certify that I have read the foregoing Registration Statement and that all of the items therein contained are true to the best of my knowledge and belief.

Lewis Mayers
(Signature of Registrant)

Subscribed and sworn to before me this 4th day of January, 19 57.

My commission expires 7-19-59

Eunice R Hart
(Notary Public)

(SEAL)

CERTIFICATE OF REGISTRATION

STATE OF OREGON
County of Marion } ss.

This is to certify that the foregoing Registration Statement was received in the office of the State Engineer on the 11th day of January, 19 57, at 10 o'clock A. M. and has been duly recorded in said office in Book No. 2 of Registration Statements on page GR-310 C

~~Construction shall be completed by X-X-X-X-X-X-X-X-X-X-X and the water completely applied to beneficial use by X-X-X-X-X-X-X-X-X-X-X.~~

Witness my hand this 11th day of March, 19 57.

Fee $15.00

Lewis A. Stanley
(State Engineer)

By
(Deputy)

GR-310 C