


Township 55 Range 3W W.M.

North

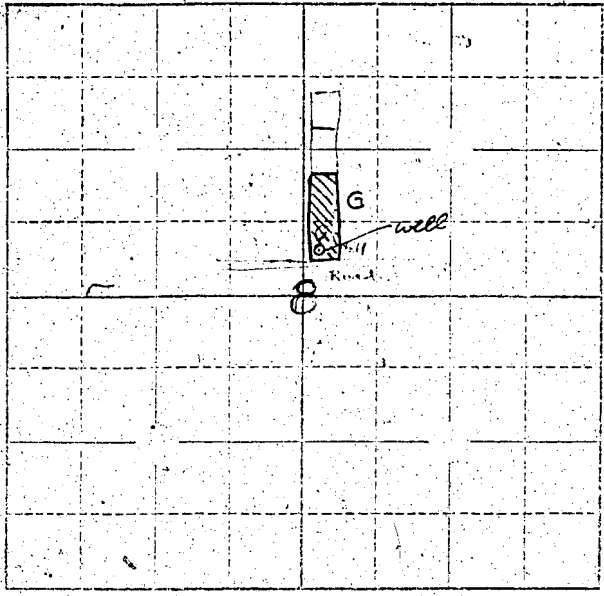

Locate well and acreage of irrigated land on plat.

Scale: $\frac{1}{4}$ " = 1 Mile

STATE OF OREGON

County of Marion } ss.

I, A. Leo Schrammick being first duly sworn, do hereby certify that I have read the foregoing Registration Statement and that all of the items therein contained are true to the best of my knowledge and belief.

A. Leo Schrammick
(Signature of Registrant)

Subscribed and sworn to before me this 30th day of July 19 58

My commission expires 12th June 1961 Wm. S. Bartholomew
(Notary Public)

(SEAL)

CERTIFICATE OF REGISTRATION

STATE OF OREGON }
County of Marion } ss.

This is to certify that the foregoing Registration Statement was received in the office of the State Engineer on the 30th day of July, 19 58, at 4:45 o'clock P. M. and has been duly recorded in said office in Book No. 13 of Registration Statements on page GR-3053

~~Construction shall be completed by _____ and the same completely completed by _____~~

Witness my hand this 8th day of June, 19 59

Wm. A. Jones
(State Engineer)

\$15.00

By _____ (Deputy)
GR-3053