
		Townsh	ip	65	Range.	200	, W	M.			il i
					orth						,
		1		1 d 2.		C					
		i 		i I		<u> </u> ©		<u> </u>			
					į		 a				
							J				
		 -				<u> </u>					
						1]		
			-								
		Locate	well and	acreag	e of irri	gated la	nd on pl	at.		1 3	
				Scale: 2	"—1 M	ile					
STATE OF OREGON					·) `						i Tagʻilg
County of	Marie	n			SS.						
read the foregoing Reg my knowledge and bel	ief.				Do	~ot	ny B		Registrant)	sku.	\ <u>\</u>
Subscribed and s	worn to	before r	ne this .	2/00	. day of	/.7.	Jul	2 2 L	Lb.	, <u>19 රිළ</u>	
My commission expires	120	Jus	e 144	Z [WM	0.10	(Notary P	ublic)		
(SEAL)		C E	BTIFIC.	ATE O	F. REGI	STRAT	ION				
											500
STATE OF OREGON	ss.			· 🔊 .						*	
County of Marion) *	ne foreg	oing Re	- Øistrati	on Stat	ement.	was red	eived i	n the of	fice of the	Stat
County of Marion This is to certify	that th	13	A 10 11 11	5.70	10 to		·				
County of Marion This is to certify Engineer on the 3/21	that the	f	July		, 19. <i>S</i> E	, at	8.00	o'clo	ck A	M. and ha	s bee
County of Marion This is to certify	y that the day of the	f Book No	Juliz	3	., 19. 2 of Regis	, at	8.00	o'clo	ck A	M. and ha	s bee
County of Marion This is to certify Engineer on the 3/20 duly recorded in said o	y that the day of the	f Book No	Juliz	3	., 19. 2 of Regis	, at	8.00	o'clo	ck A	M. and ha	s bee

T.6S., R.2W., W.M.

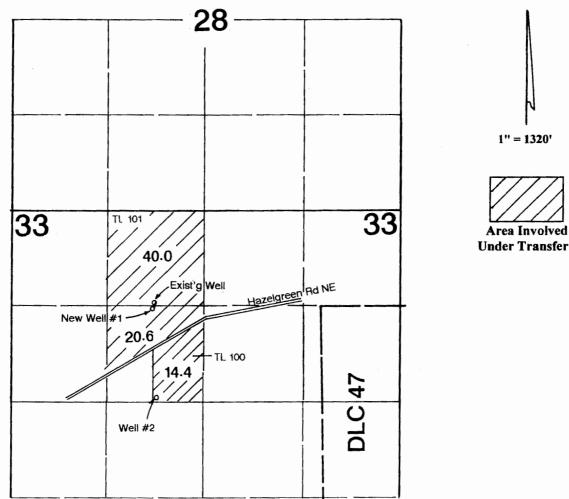

Exist'g Well is located 20' N & 650' W from the SE corner of NE1/4-NW1/4, Section 33. New Well #1 (New POA) is located 30' S & 660' W from the SE corner of NE1/4-NW1/4, Section 33. Well #2 (APOA) is located 20' N & 2040' E from the W1/4 corner of Section 33.

Application Map

Pan American Berry Growers LLC.

Transfer #:

This Map was Prepared for the Purpose of Identifying the Location of a Water Right Only and is Not Intended to Provide Legal Dimensions or Location of Property Ownership Lines.

RECEIVED

FEB 26 2015

11990 44

WATER RESOURCES DEPT SALEM, OREGON

