


Township 4-5 Range 3 - W. W.M.  
North *red st*

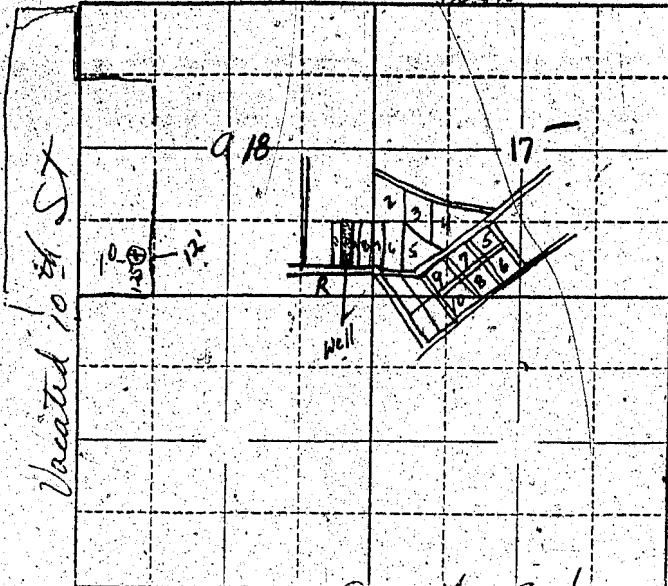

Locate well and acreage of irrigated land on plat.

Scale: 2" = 1 Mile

STATE OF OREGON

County of *Yamhill*

{ss}

I, Lanada G. McFee, being first duly sworn, do hereby certify that I have read the foregoing Registration Statement and that all of the items therein contained are true to the best of my knowledge and belief.

*Lanada G. McFee*  
(Signature of Registrant)

Subscribed and sworn to before me this 23 day of June, 1958.

My commission expires Jan. 26, 1959

*Ronnie E. Rogers*  
(Notary Public)

(SEAL)

### CERTIFICATE OF REGISTRATION

STATE OF OREGON

County of Marion

{ss}

This is to certify that the foregoing Registration Statement was received in the office of the State Engineer on the 31st day of July, 1958, at 8:00 o'clock A.M. and has been duly recorded in said office in Book No. 17 of Registration Statements on page GR-4081.

~~Construction shall be completed by 1958 and the water completely diverted by 1959~~

Witness my hand this 16<sup>th</sup> day of May, 1960.

LEWIS A. STANLEY

(State Engineer)

By *L.A.S. Rogers*  
Max F. Rogers (Deputy)

\$15.00

*GR-4081*